
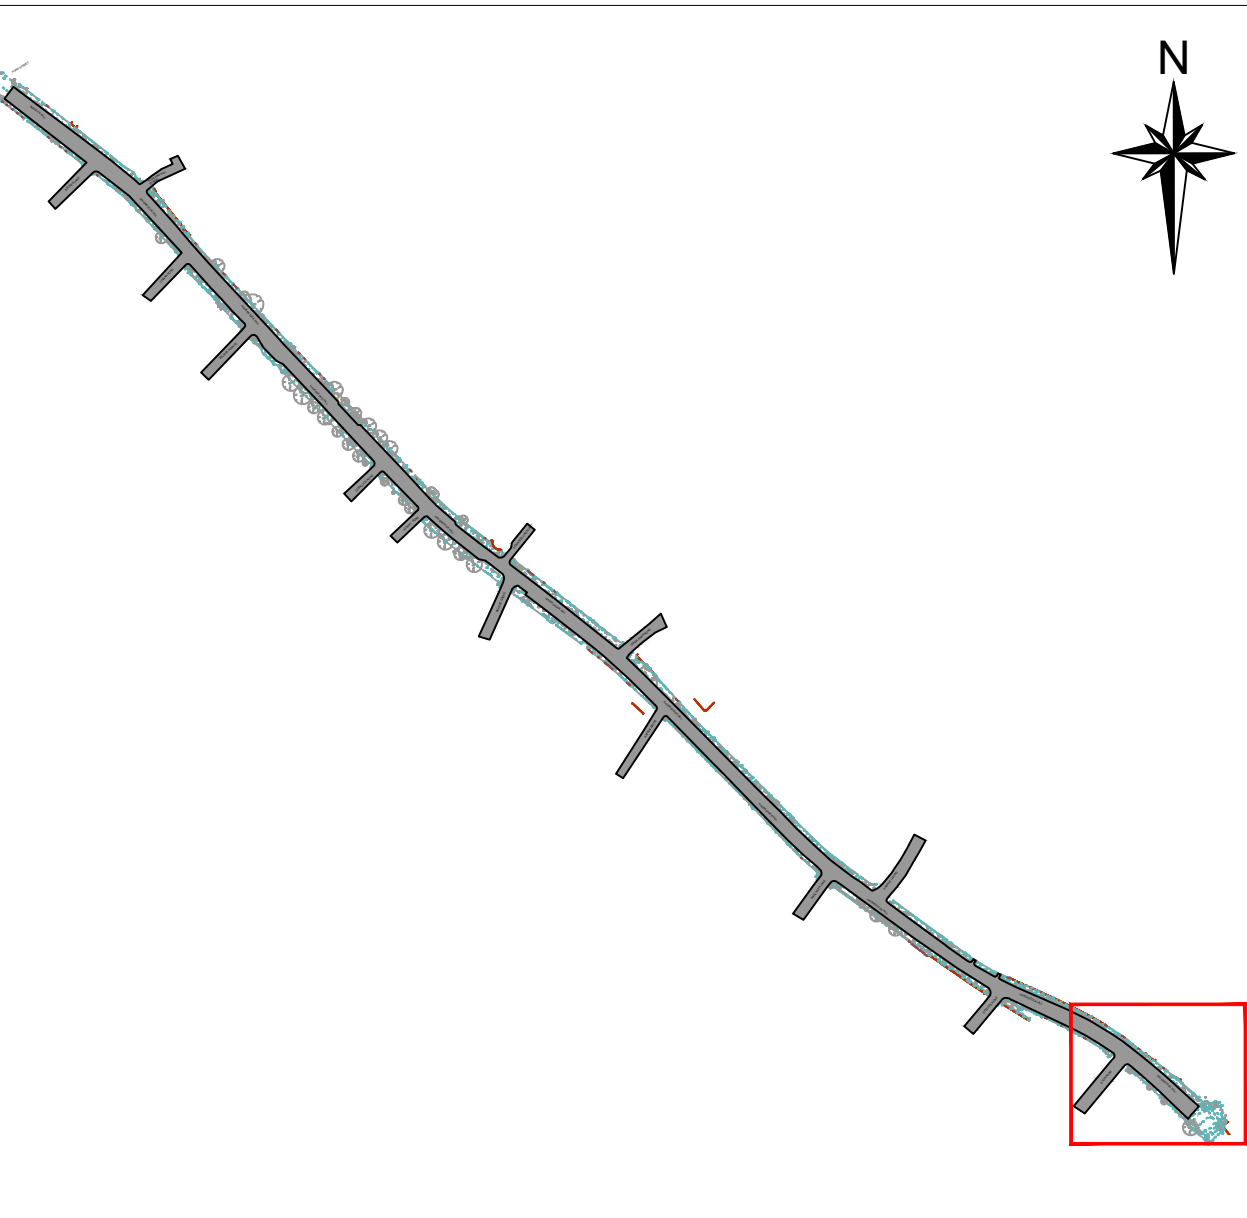


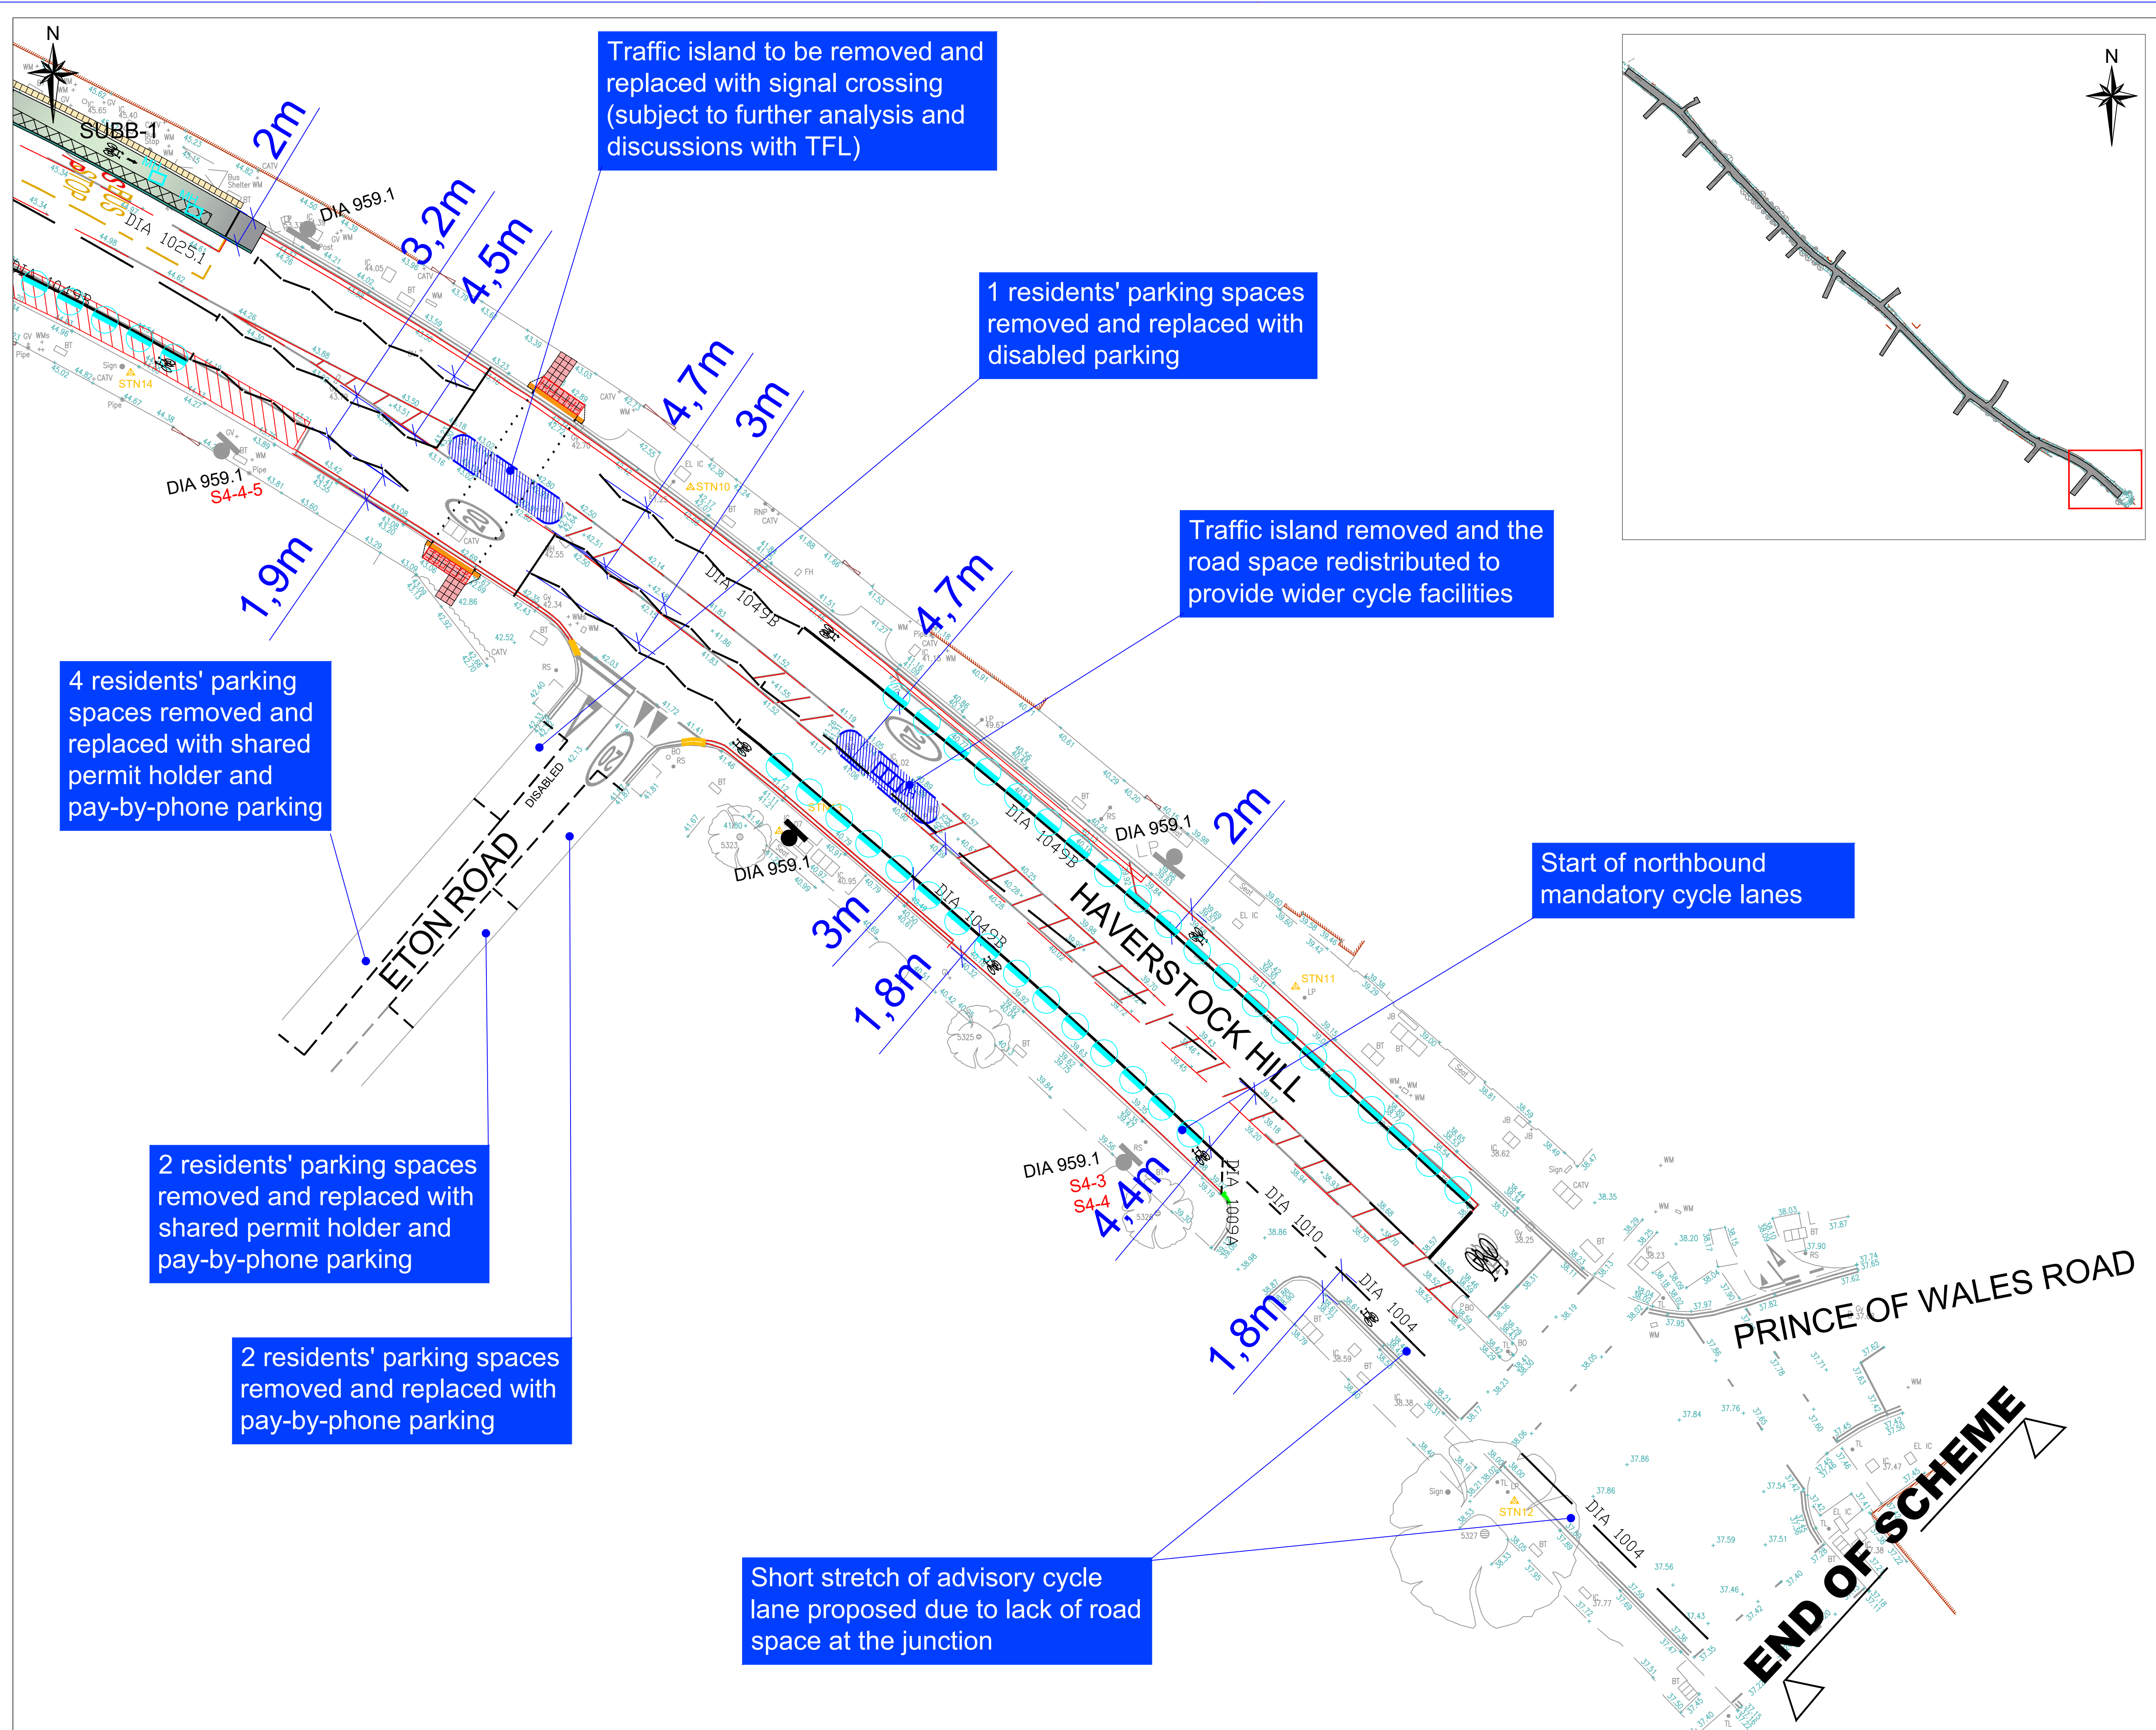

- KEY:**
- NEW DOUBLE YELLOW LINE MARKING / EXISTING TO BE REFRESHED
 - ROAD MARKINGS TO BE REMOVED
 - EXISTING LAYOUT TO BE RETAINED
 - TRAFFIC ISLAND TO BE REMOVED
 - PARKING BAY REMOVED
 - ELECTRIC VEHICLE CHARGING BAY REMOVED
 - CAR CLUB BAYS REMOVED
 - DISABLED BAYS REMOVED
 - NEW DISABLED BAY 3HRS MAX STAY
 - NEW OR REVISED PARKING BAY
 - NEW ELECTRIC VEHICLE CHARGING BAY
 - NEW CAR CLUB BAY
 - KERBS TO BE REMOVED
 - NEW KERBS LINE
 - NEW DROPPED KERB
 - NEW ARTIFICIAL STONE PAVING
 - NEW MASTIC ASPHALT PAVING
 - NEW PAVING BLOCKS
 - NEW BUFF TACTILE PAVING
 - NEW RED TACTILE PAVING
 - MANHOLE COVER REPLACED TO MATCH NEW USE
 - MANHOLE DROPPED TO MATCH SURROUNDING LEVELS AND COVER REPLACED TO MATCH NEW USE
 - MANHOLE RAISED TO MATCH SURROUNDING LEVELS AND COVER RETAINED
 - TACTILE PAVING TO BE REMOVED
 - NEW 24/7 MANDATORY CYCLE LANES AND CYCLE LOGOS (DIA 1057)
 - INSTALL TRAFFIC SIGNS REGULATION AND GENERAL DIRECTION DIAGRAM NUMBER
 - REMOVE TRAFFIC SIGNS REGULATION AND GENERAL DIRECTION DIAGRAM NUMBER TO STORAGE
 - EXISTING LAMP COLUMN AND NEW SIGNS
 - NEW POST AND SIGN
 - EXISTING POST AND SIGN
 - NEW SHARED USE BUS BOARDERS (SUBB) WITH TACTILE PAVING
 - NEW ZEBRA CROSSING (DIA 1001.4)
 - WAND ORCAS INSTALLED @ 2.5M SPACING
 - NEW BELISHA BEACON

- NOTES:**
- ALL ITEMS SHOWN RED ARE TO BE REMOVED, GREY ARE TO BE MAINTAINED AND BLACK ARE TO BE INSTALLED AS PART OF WORK
 - THIS DRAWING IS BASED ON CD SURVEYS LTD TOPOGRAPHICAL SURVEY DRAWING NO. 2008045 - HAVERSTOCK HILL, LONDON FINAL
 - THIS AND ALL DRAWINGS ARE TO BE READ IN CONJUNCTION WITH THE SPECIFICATION FOR HIGHWAY WORKS AND OTHER SCHEME DRAWINGS
 - IF IN DOUBT OF ANY ASPECT OF THE DESIGN REFER TO THE LEAD DESIGNER FOR CLARIFICATION
 - EXISTING ACCESSES SHOULD BE MAINTAINED AT ALL TIMES AND NOT OBSTRUCTED UNLESS WITH PRIOR CONSENT FROM AFFECTED PARTIES
 - A MINIMUM FOOTWAY WIDTH OF 1.5M (OR AN ABSOLUTE MINIMUM OF 1M, OVER A MAXIMUM LENGTH OF 6M) SHOULD BE MAINTAINED DURING SITE CLEARANCE
 - ALL EXISTING LIGHTING COLUMNS, ILLUMINATED BOLLARDS OR ROAD SIGNS ARE TO BE DISCONNECTED AND MADE SAFE BEFORE REMOVALS
 - CONTRACTOR TO ENSURE TREE ROOTS ARE PROTECTED DURING EXCAVATION WORKS AROUND TREES
 - WAND ORCAS ARE TO BE POSITIONED ON THE INSIDE OF MANDATORY CYCLE LANE MARKINGS
 - MANDATORY CYCLE LANE DIMENSIONS ARE FROM THE KERB FACE TO THE OUTSIDE OF THE MANDATORY WHITE LINE MARKINGS

A	WH	23/06/20	Amendments to notes and drawing
B	WH	19/08/20	Amendments to notes and drawing
C	WH	09/10/20	Amendments to crossings and lanes
D	WH	26/10/20	Amendments to parking and loading

Rev	By	Date	Amendments
-----	----	------	------------





Design Team
Transport Strategy Service
London Borough of Camden
5 Pancras Square
Tel 020 7974 5551, Fax 020 7974 6952
DX 2106 Euston, Minicom 020 7974 6866

Project
**CYCLE POP-UP SCHEME
HAVERSTOCK HILL**

Drawing Title
GENERAL ARRANGEMENTS

Scale 1 : 200 @ A1	Date JUNE 2020
Drawn By WH	File Ref T:\Cap_Sm\2019\2019\CYCLE POP-UP\Haverstock Hill
Checked By SS	Dwg Name CYCLE POP-UP
Drawing Location -	
Drawing Number SSF/000-CS-100-01-001	Rev. D

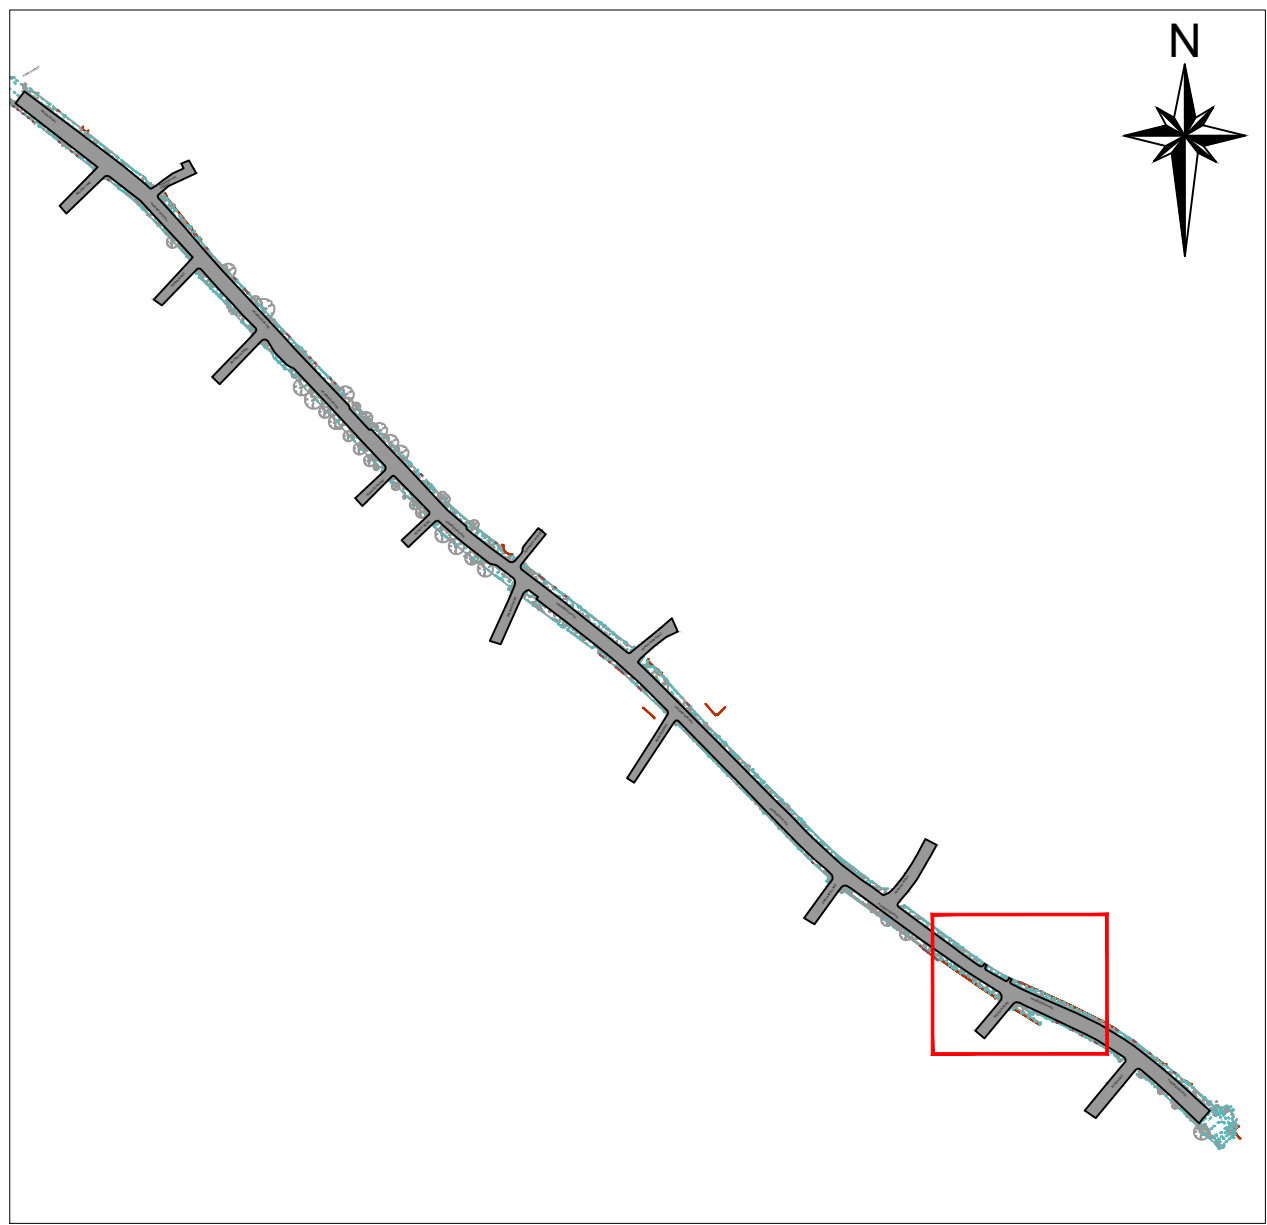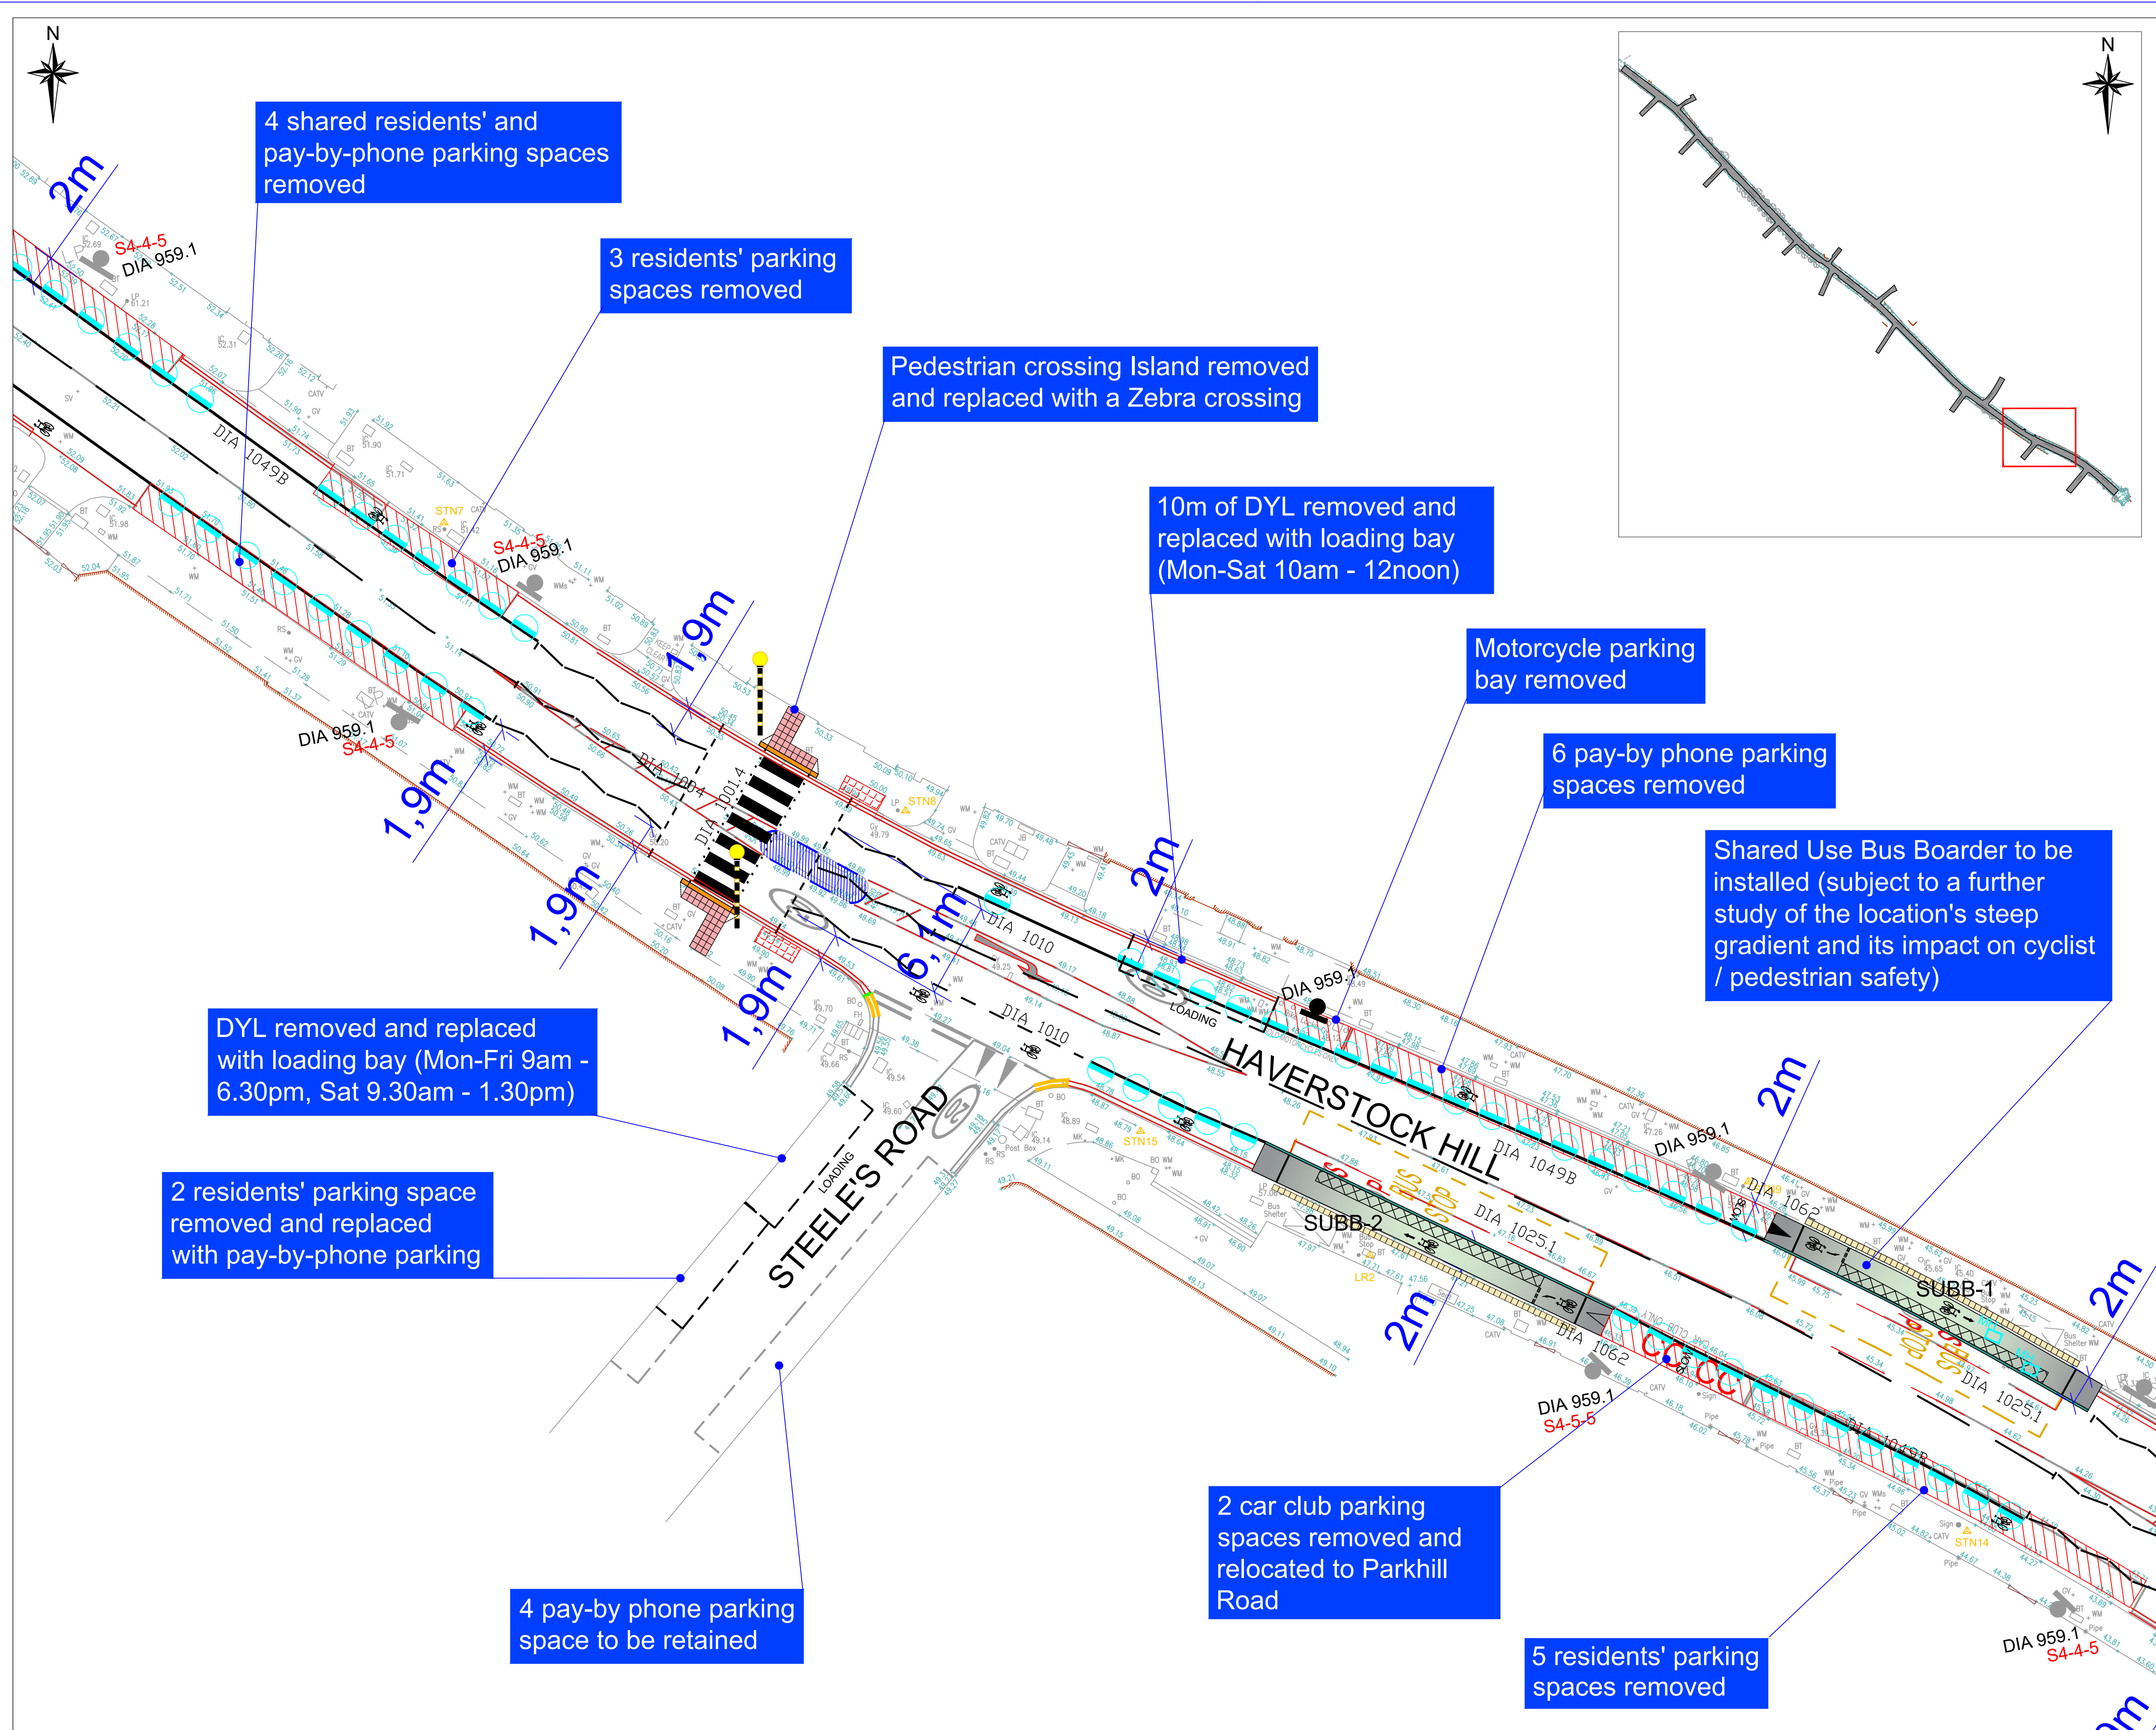

- KEY:**
- NEW DOUBLE YELLOW LINE MARKING / EXISTING TO BE REFRESHED
 - ROAD MARKINGS TO BE REMOVED
 - EXISTING LAYOUT TO BE RETAINED
 - TRAFFIC ISLAND TO BE REMOVED
 - PARKING BAY REMOVED
 - ELECTRIC VEHICLE CHARGING BAY REMOVED
 - CAR CLUB BAYS REMOVED
 - DISABLED BAYS REMOVED
 - NEW DISABLED BAY 3HRS MAX STAY
 - NEW OR REVISED PARKING BAY
 - NEW ELECTRIC VEHICLE CHARGING BAY
 - NEW CAR CLUB BAY
 - KERBS TO BE REMOVED
 - NEW KERBS LINE
 - NEW DROPPED KERB
 - NEW ARTIFICIAL STONE PAVING
 - NEW MASTIC ASPHALT PAVING
 - NEW PAVING BLOCKS
 - NEW BUFF TACTILE PAVING
 - NEW RED TACTILE PAVING
 - MANHOLE COVER REPLACED TO MATCH NEW USE
 - MANHOLE DROPPED TO MATCH SURROUNDING LEVELS AND COVER REPLACED TO MATCH NEW USE
 - MANHOLE RAISED TO MATCH SURROUNDING LEVELS AND COVER RETAINED
 - TACTILE PAVING TO BE REMOVED
 - NEW 24/7 MANDATORY CYCLE LANES AND CYCLE LOGOS (DIA 1057)
 - DIA 0000
 - INSTALL TRAFFIC SIGNS REGULATION AND GENERAL DIRECTION DIAGRAM NUMBER
 - REMOVE TRAFFIC SIGNS REGULATION AND GENERAL DIRECTION DIAGRAM NUMBER TO STORAGE
 - EXISTING LAMP COLUMN AND NEW SIGNS
 - NEW POST AND SIGN
 - EXISTING POST AND SIGN
 - NEW SHARED USE BUS BOARDERS (SUBB) WITH TACTILE PAVING
 - NEW ZEBRA CROSSING (DIA 1001.4)
 - WAND ORCAS INSTALLED @ 2.5M SPACING
 - NEW BELISHA BEACON

- NOTES:**
- ALL ITEMS SHOWN RED ARE TO BE REMOVED, GREY ARE TO BE MAINTAINED AND BLACK ARE TO BE INSTALLED AS PART OF WORK
 - THIS DRAWING IS BASED ON CD SURVEYS LTD TOPOGRAPHICAL SURVEY DRAWING NO. 2008046 - HAVERSTOCK HILL, LONDON FINAL
 - THIS AND ALL DRAWINGS ARE TO BE READ IN CONJUNCTION WITH THE SPECIFICATION FOR HIGHWAY WORKS AND OTHER SCHEME DRAWINGS
 - IF IN DOUBT OF ANY ASPECT OF THE DESIGN REFER TO THE LEAD DESIGNER FOR CLARIFICATION
 - EXISTING ACCESSES SHOULD BE MAINTAINED AT ALL TIMES AND NOT OBSTRUCTED UNLESS WITH PRIOR CONSENT FROM AFFECTED PARTIES
 - A MINIMUM FOOTWAY WIDTH OF 1.5M (OR AN ABSOLUTE MINIMUM OF 1M, OVER A MAXIMUM LENGTH OF 6M) SHOULD BE MAINTAINED DURING SITE CLEARANCE
 - ALL EXISTING LIGHTING COLUMNS, ILLUMINATED BOLLARDS OR ROAD SIGNS ARE TO BE DISCONNECTED AND MADE SAFE BEFORE REMOVALS
 - CONTRACTOR TO ENSURE TREE ROOTS ARE PROTECTED DURING EXCAVATION WORKS AROUND TREES.
 - WAND ORCAS ARE TO BE POSITIONED ON THE INSIDE OF MANDATORY CYCLE LANE MARKINGS
 - MANDATORY CYCLE LANE DIMENSIONS ARE FROM THE KERB FACE TO THE OUTSIDE OF THE MANDATORY WHITE LINE MARKINGS

A	WH	23/06/20	Amendments to notes and drawing
B	WH	19/08/20	Amendments to notes and drawing
C	WH	09/10/20	Amendments to crossings and lanes
D	WH	26/10/20	Amendments to parking and loading

Rev	By	Date	Amendments
-----	----	------	------------





Design Team
Transport Strategy Service
London Borough of Camden
5 Pancras Square
Tel 020 7974 5551, Fax 020 7974 6952
DX 2106 Euston, Minicom 020 7974 6866

Project
**CYCLE POP-UP SCHEME
HAVERSTOCK HILL**

Drawing Title
GENERAL ARRANGEMENTS

Scale 1 : 200 @ A1	Date JUNE 2020
Drawn By WH	File Ref T:\Cap_Sm\2019\20/CYCLE POPUP/Haverstock H
Checked By SS	Dwg Name CYCLE POP-UP
Drawing Location -	
Drawing Number SSF/000-CS-100-01-002	Rev. D

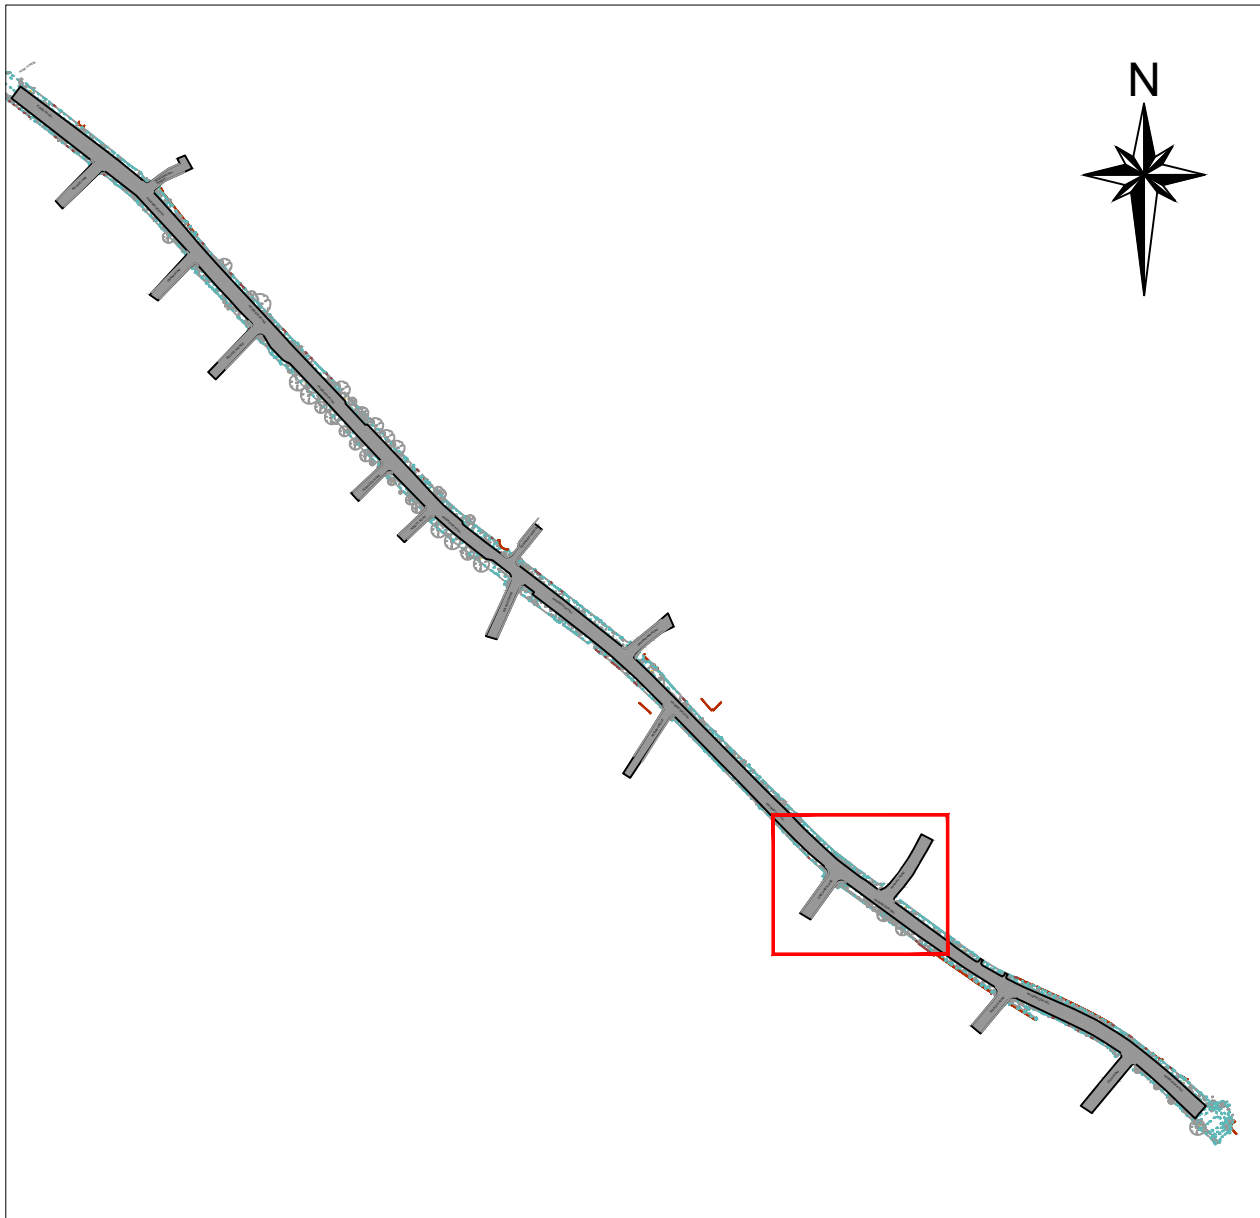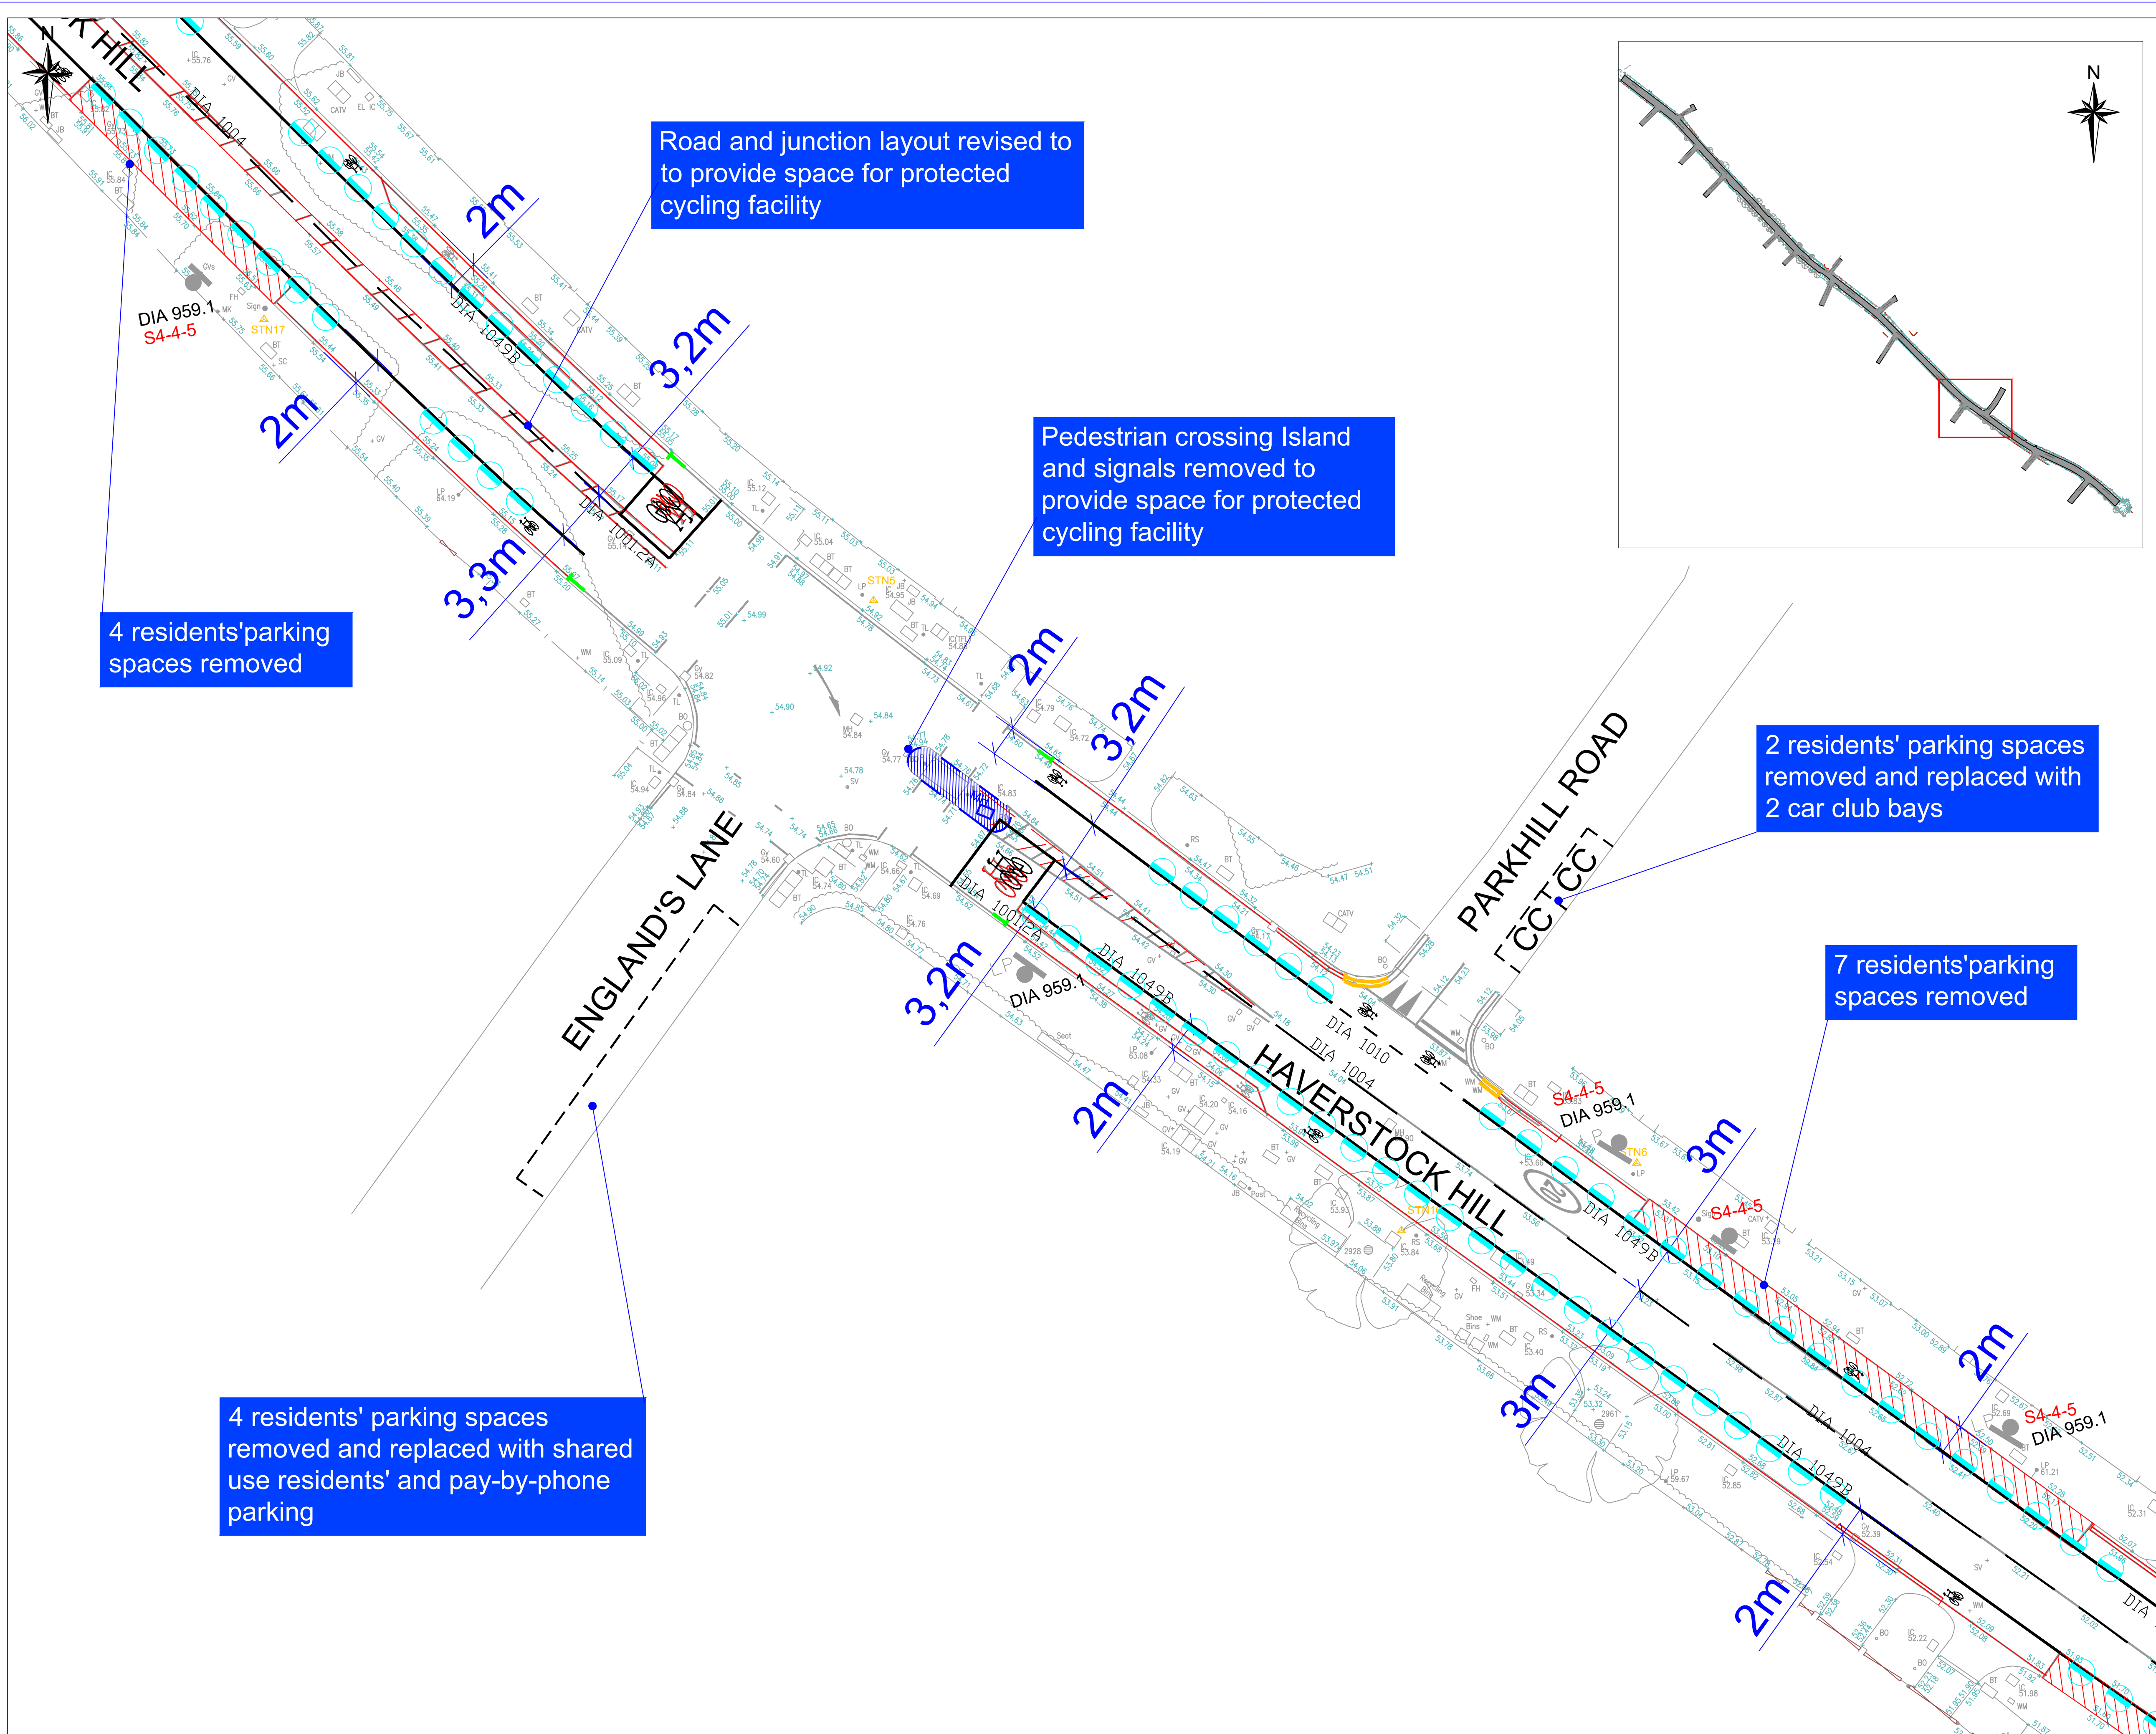

- KEY:**
- NEW DOUBLE YELLOW LINE MARKING / EXISTING TO BE REFRESHED
 - ROAD MARKINGS TO BE REMOVED
 - EXISTING LAYOUT TO BE RETAINED
 - TRAFFIC ISLAND TO BE REMOVED
 - PARKING BAY REMOVED
 - ELECTRIC VEHICLE CHARGING BAY REMOVED
 - CAR CLUB BAYS REMOVED
 - DISABLED BAYS REMOVED
 - NEW DISABLED BAY 3HRS MAX STAY
 - NEW OR REVISED PARKING BAY
 - NEW ELECTRIC VEHICLE CHARGING BAY
 - NEW CAR CLUB BAY
 - KERBS TO BE REMOVED
 - NEW KERBS LINE
 - NEW DROPPED KERB
 - NEW ARTIFICIAL STONE PAVING
 - NEW MASTIC ASPHALT PAVING
 - NEW PAVING BLOCKS
 - NEW BUFF TACTILE PAVING
 - NEW RED TACTILE PAVING
 - MANHOLE COVER REPLACED TO MATCH NEW USE
 - MANHOLE DROPPED TO MATCH SURROUNDING LEVELS AND COVER REPLACED TO MATCH NEW USE
 - MANHOLE RAISED TO MATCH SURROUNDING LEVELS AND COVER RETAINED
 - TACTILE PAVING TO BE REMOVED
 - NEW 24/7 MANDATORY CYCLE LANES AND CYCLE LOGOS (DIA 1057)
 - DIA 0000
 - INSTALL TRAFFIC SIGNS REGULATION AND GENERAL DIRECTION DIAGRAM NUMBER
 - REMOVE TRAFFIC SIGNS REGULATION AND GENERAL DIRECTION DIAGRAM NUMBER TO STORAGE
 - S4-0-0
 - EXISTING LAMP COLUMN AND NEW SIGNS
 - NEW POST AND SIGN
 - EXISTING POST AND SIGN
 - NEW SHARED USE BUS BOARDERS (SUBB) WITH TACTILE PAVING
 - NEW ZEBRA CROSSING (DIA 1001.4)
 - WAND ORCAS INSTALLED @ 2.5M SPACING
 - NEW BELISHA BEACON

- NOTES:**
- ALL ITEMS SHOWN RED ARE TO BE REMOVED, GREY ARE TO BE MAINTAINED AND BLACK ARE TO BE INSTALLED AS PART OF WORK
 - THIS DRAWING IS BASED ON CD SURVEYS LTD TOPOGRAPHICAL SURVEY DRAWING NO. 2008045 - HAVERSTOCK HILL, LONDON FINAL
 - THIS AND ALL DRAWINGS ARE TO BE READ IN CONJUNCTION WITH THE SPECIFICATION FOR HIGHWAY WORKS AND OTHER SCHEME DRAWINGS
 - IF IN DOUBT OF ANY ASPECT OF THE DESIGN REFER TO THE LEAD DESIGNER FOR CLARIFICATION
 - EXISTING ACCESSES SHOULD BE MAINTAINED AT ALL TIMES AND NOT OBSTRUCTED UNLESS WITH PRIOR CONSENT FROM AFFECTED PARTIES
 - A MINIMUM FOOTWAY WIDTH OF 1.5M (OR AN ABSOLUTE MINIMUM OF 1M, OVER A MAXIMUM LENGTH OF 6M) SHOULD BE MAINTAINED DURING SITE CLEARANCE
 - ALL EXISTING LIGHTING COLUMNS, ILLUMINATED BOLLARDS OR ROAD SIGNS ARE TO BE DISCONNECTED AND MADE SAFE BEFORE REMOVALS
 - CONTRACTOR TO ENSURE TREE ROOTS ARE PROTECTED DURING EXCAVATION WORKS AROUND TREES.
 - WAND ORCAS ARE TO BE POSITIONED ON THE INSIDE OF MANDATORY CYCLE LANE MARKINGS
 - MANDATORY CYCLE LANE DIMENSIONS ARE FROM THE KERB FACE TO THE OUTSIDE OF THE MANDATORY WHITE LINE MARKINGS

A	WH	23/06/20	Amendments to notes and drawing
B	WH	19/08/20	Amendments to notes and drawing
C	WH	09/10/20	Amendments to crossings and lanes
D	WH	26/10/20	Amendments to parking and loading

Rev	By	Date	Amendments
-----	----	------	------------



Design Team
Transport Strategy Service
London Borough of Camden
5 Pancras Square
Tel 020 7974 5551, Fax 020 7974 6952
DX 2106 Euston, Minicom 020 7974 6866

Project
**CYCLE POP-UP SCHEME
HAVERSTOCK HILL**


Drawing Title
GENERAL ARRANGEMENTS

Scale 1 : 200 @ A1	Date JUNE 2020
Drawn By WH	File Ref T:\Cap_Sm2019\2020\Cycle POPUP\Haverstock H
Checked By SS	Dwg Name CYCLE POP-UP

Drawing Location
-

Drawing Number
SSF/000-CS-100-01-003

Rev.
D

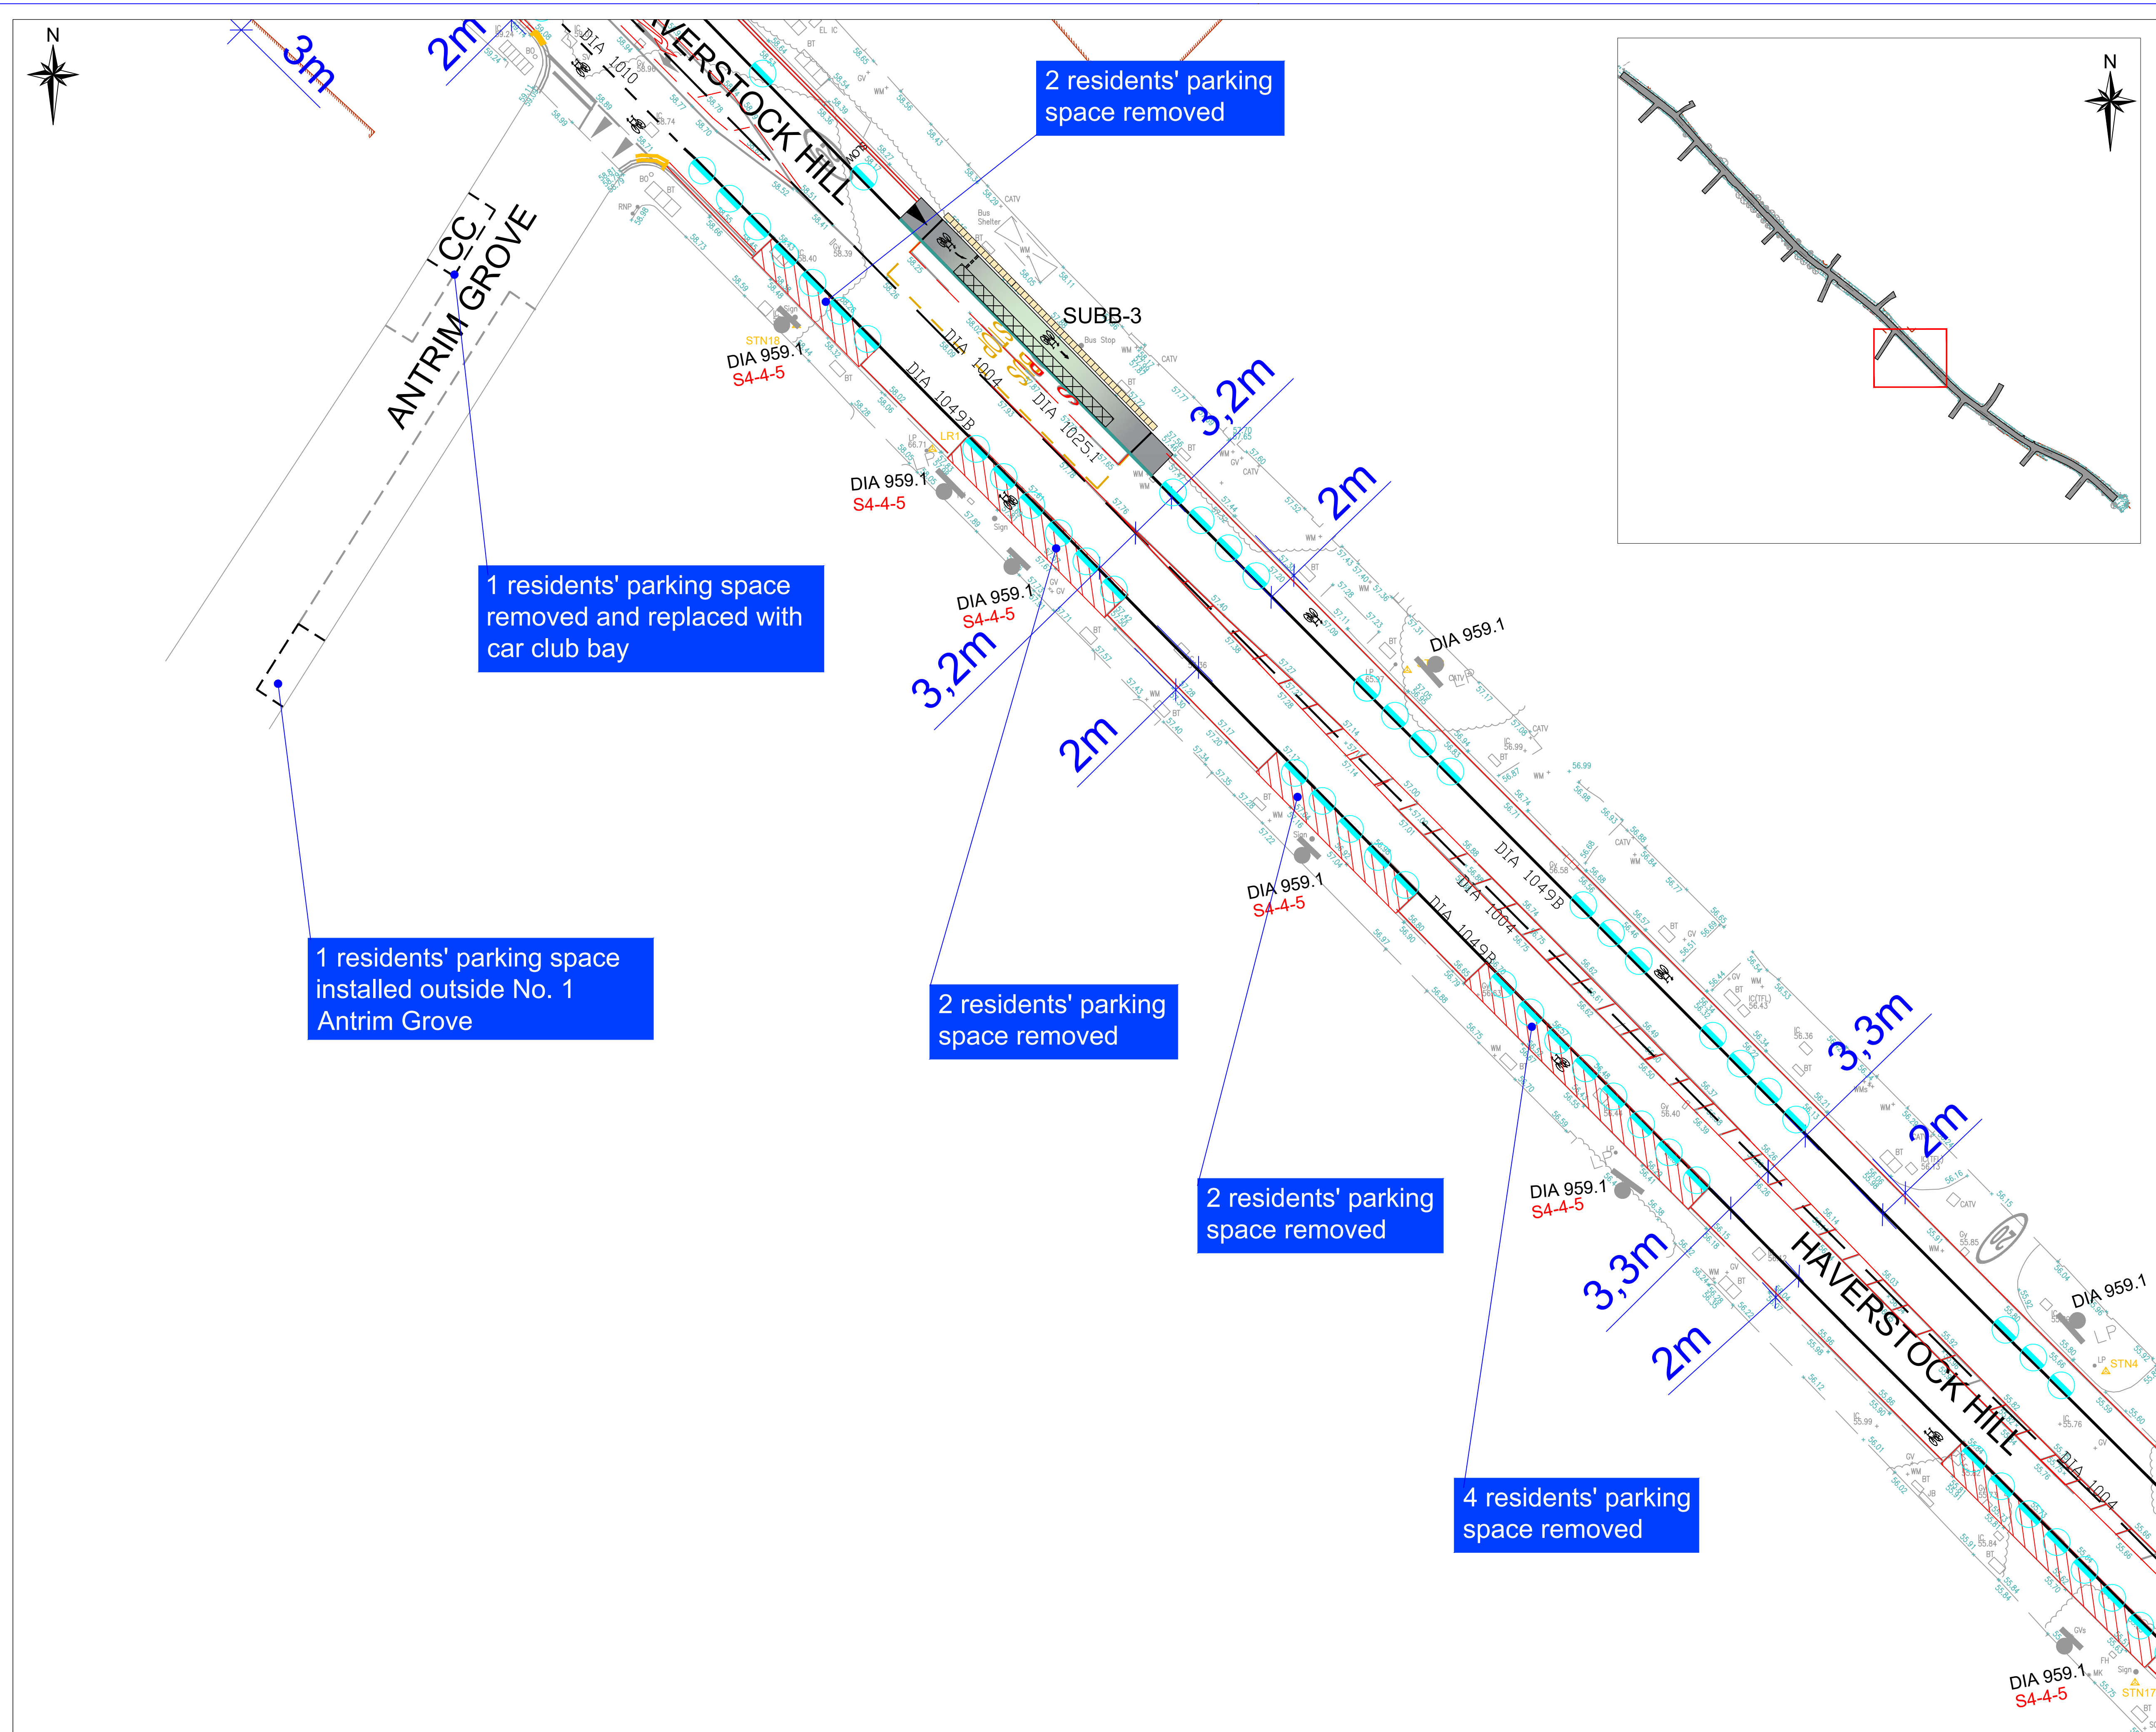

KEY:

- NEW DOUBLE YELLOW LINE MARKING / EXISTING TO BE REFRESHED
- ROAD MARKINGS TO BE REMOVED
- EXISTING LAYOUT TO BE RETAINED
- TRAFFIC ISLAND TO BE REMOVED
- PARKING BAY REMOVED
- ELECTRIC VEHICLE CHARGING BAY REMOVED
- CAR CLUB BAYS REMOVED
- DISABLED BAYS REMOVED
- DIS
- NEW DISABLED BAY 3HRS MAX STAY
- NEW OR REVISED PARKING BAY
- NEW ELECTRIC VEHICLE CHARGING BAY
- NEW CAR CLUB BAY
- KERBS TO BE REMOVED
- NEW KERBS LINE
- NEW DROPPED KERB
- NEW ARTIFICIAL STONE PAVING
- NEW MASTIC ASPHALT PAVING
- NEW PAVING BLOCKS
- NEW BUFF TACTILE PAVING
- NEW RED TACTILE PAVING
- MANHOLE COVER REPLACED TO MATCH NEW USE
- MANHOLE DROPPED TO MATCH SURROUNDING LEVELS AND COVER REPLACED TO MATCH NEW USE
- MANHOLE RAISED TO MATCH SURROUNDING LEVELS AND COVER RETAINED
- TACTILE PAVING TO BE REMOVED
- NEW 24/7 MANDATORY CYCLE LANES AND CYCLE LOGOS (DIA 1057)
- DIA 0000
- INSTALL TRAFFIC SIGNS REGULATION AND GENERAL DIRECTION DIAGRAM NUMBER
- REMOVE TRAFFIC SIGNS REGULATION AND GENERAL DIRECTION DIAGRAM NUMBER TO STORAGE
- EXISTING LAMP COLUMN AND NEW SIGNS
- NEW POST AND SIGN
- EXISTING POST AND SIGN
- NEW SHARED USE BUS BOARDERS (SUBB) WITH TACTILE PAVING
- NEW ZEBRA CROSSING (DIA 1001.4)
- WAND ORCAS INSTALLED @ 2.5M SPACING
- NEW BELISHA BEACON

- NOTES:**
- ALL ITEMS SHOWN RED ARE TO BE REMOVED, GREY ARE TO BE MAINTAINED AND BLACK ARE TO BE INSTALLED AS PART OF WORK
 - THIS DRAWING IS BASED ON CD SURVEYS LTD TOPOGRAPHICAL SURVEY DRAWING NO. 2008045 - HAVERSTOCK HILL, LONDON FINAL
 - THIS AND ALL DRAWINGS ARE TO BE READ IN CONJUNCTION WITH THE SPECIFICATION FOR HIGHWAY WORKS AND OTHER SCHEME DRAWINGS
 - IF IN DOUBT OF ANY ASPECT OF THE DESIGN REFER TO THE LEAD DESIGNER FOR CLARIFICATION
 - EXISTING ACCESSES SHOULD BE MAINTAINED AT ALL TIMES AND NOT OBSTRUCTED UNLESS WITH PRIOR CONSENT FROM AFFECTED PARTIES
 - A MINIMUM FOOTWAY WIDTH OF 1.5M (OR AN ABSOLUTE MINIMUM OF 1M, OVER A MAXIMUM LENGTH OF 6M) SHOULD BE MAINTAINED DURING SITE CLEARANCE
 - ALL EXISTING LIGHTING COLUMNS, ILLUMINATED BOLLARDS OR ROAD SIGNS ARE TO BE DISCONNECTED AND MADE SAFE BEFORE REMOVALS
 - CONTRACTOR TO ENSURE TREE ROOTS ARE PROTECTED DURING EXCAVATION WORKS AROUND TREES
 - WAND ORCAS ARE TO BE POSITIONED ON THE INSIDE OF MANDATORY CYCLE LANE MARKINGS
 - MANDATORY CYCLE LANE DIMENSIONS ARE FROM THE KERB FACE TO THE OUTSIDE OF THE MANDATORY WHITE LINE MARKINGS

A	WH	23/06/20	Amendments to notes and drawing
B	WH	19/08/20	Amendments to notes and drawing
C	WH	09/10/20	Amendments to crossings and lanes
D	WH	26/10/20	Amendments to parking and loading

Rev	By	Date	Amendments
-----	----	------	------------




Design Team
Transport Strategy Service
London Borough of Camden
5 Pancras Square
Tel 020 7974 5551, Fax 020 7974 6952
DX 2106 Euston, Minicom 020 7974 6866

Project
**CYCLE POP-UP SCHEME
HAVERSTOCK HILL**

Drawing Title
GENERAL ARRANGEMENTS

Scale 1 : 200 @ A1	Date JUNE 2020
Drawn By WH	File Ref T:\Cap_Sm2019\2019\CYCLE POP-UP\Haverstock H
Checked By SS	Dwg Name CYCLE POP-UP

Drawing Location -	Drawing Number SSF/000-CS-100-01-004	Rev. D
-----------------------	--	------------------

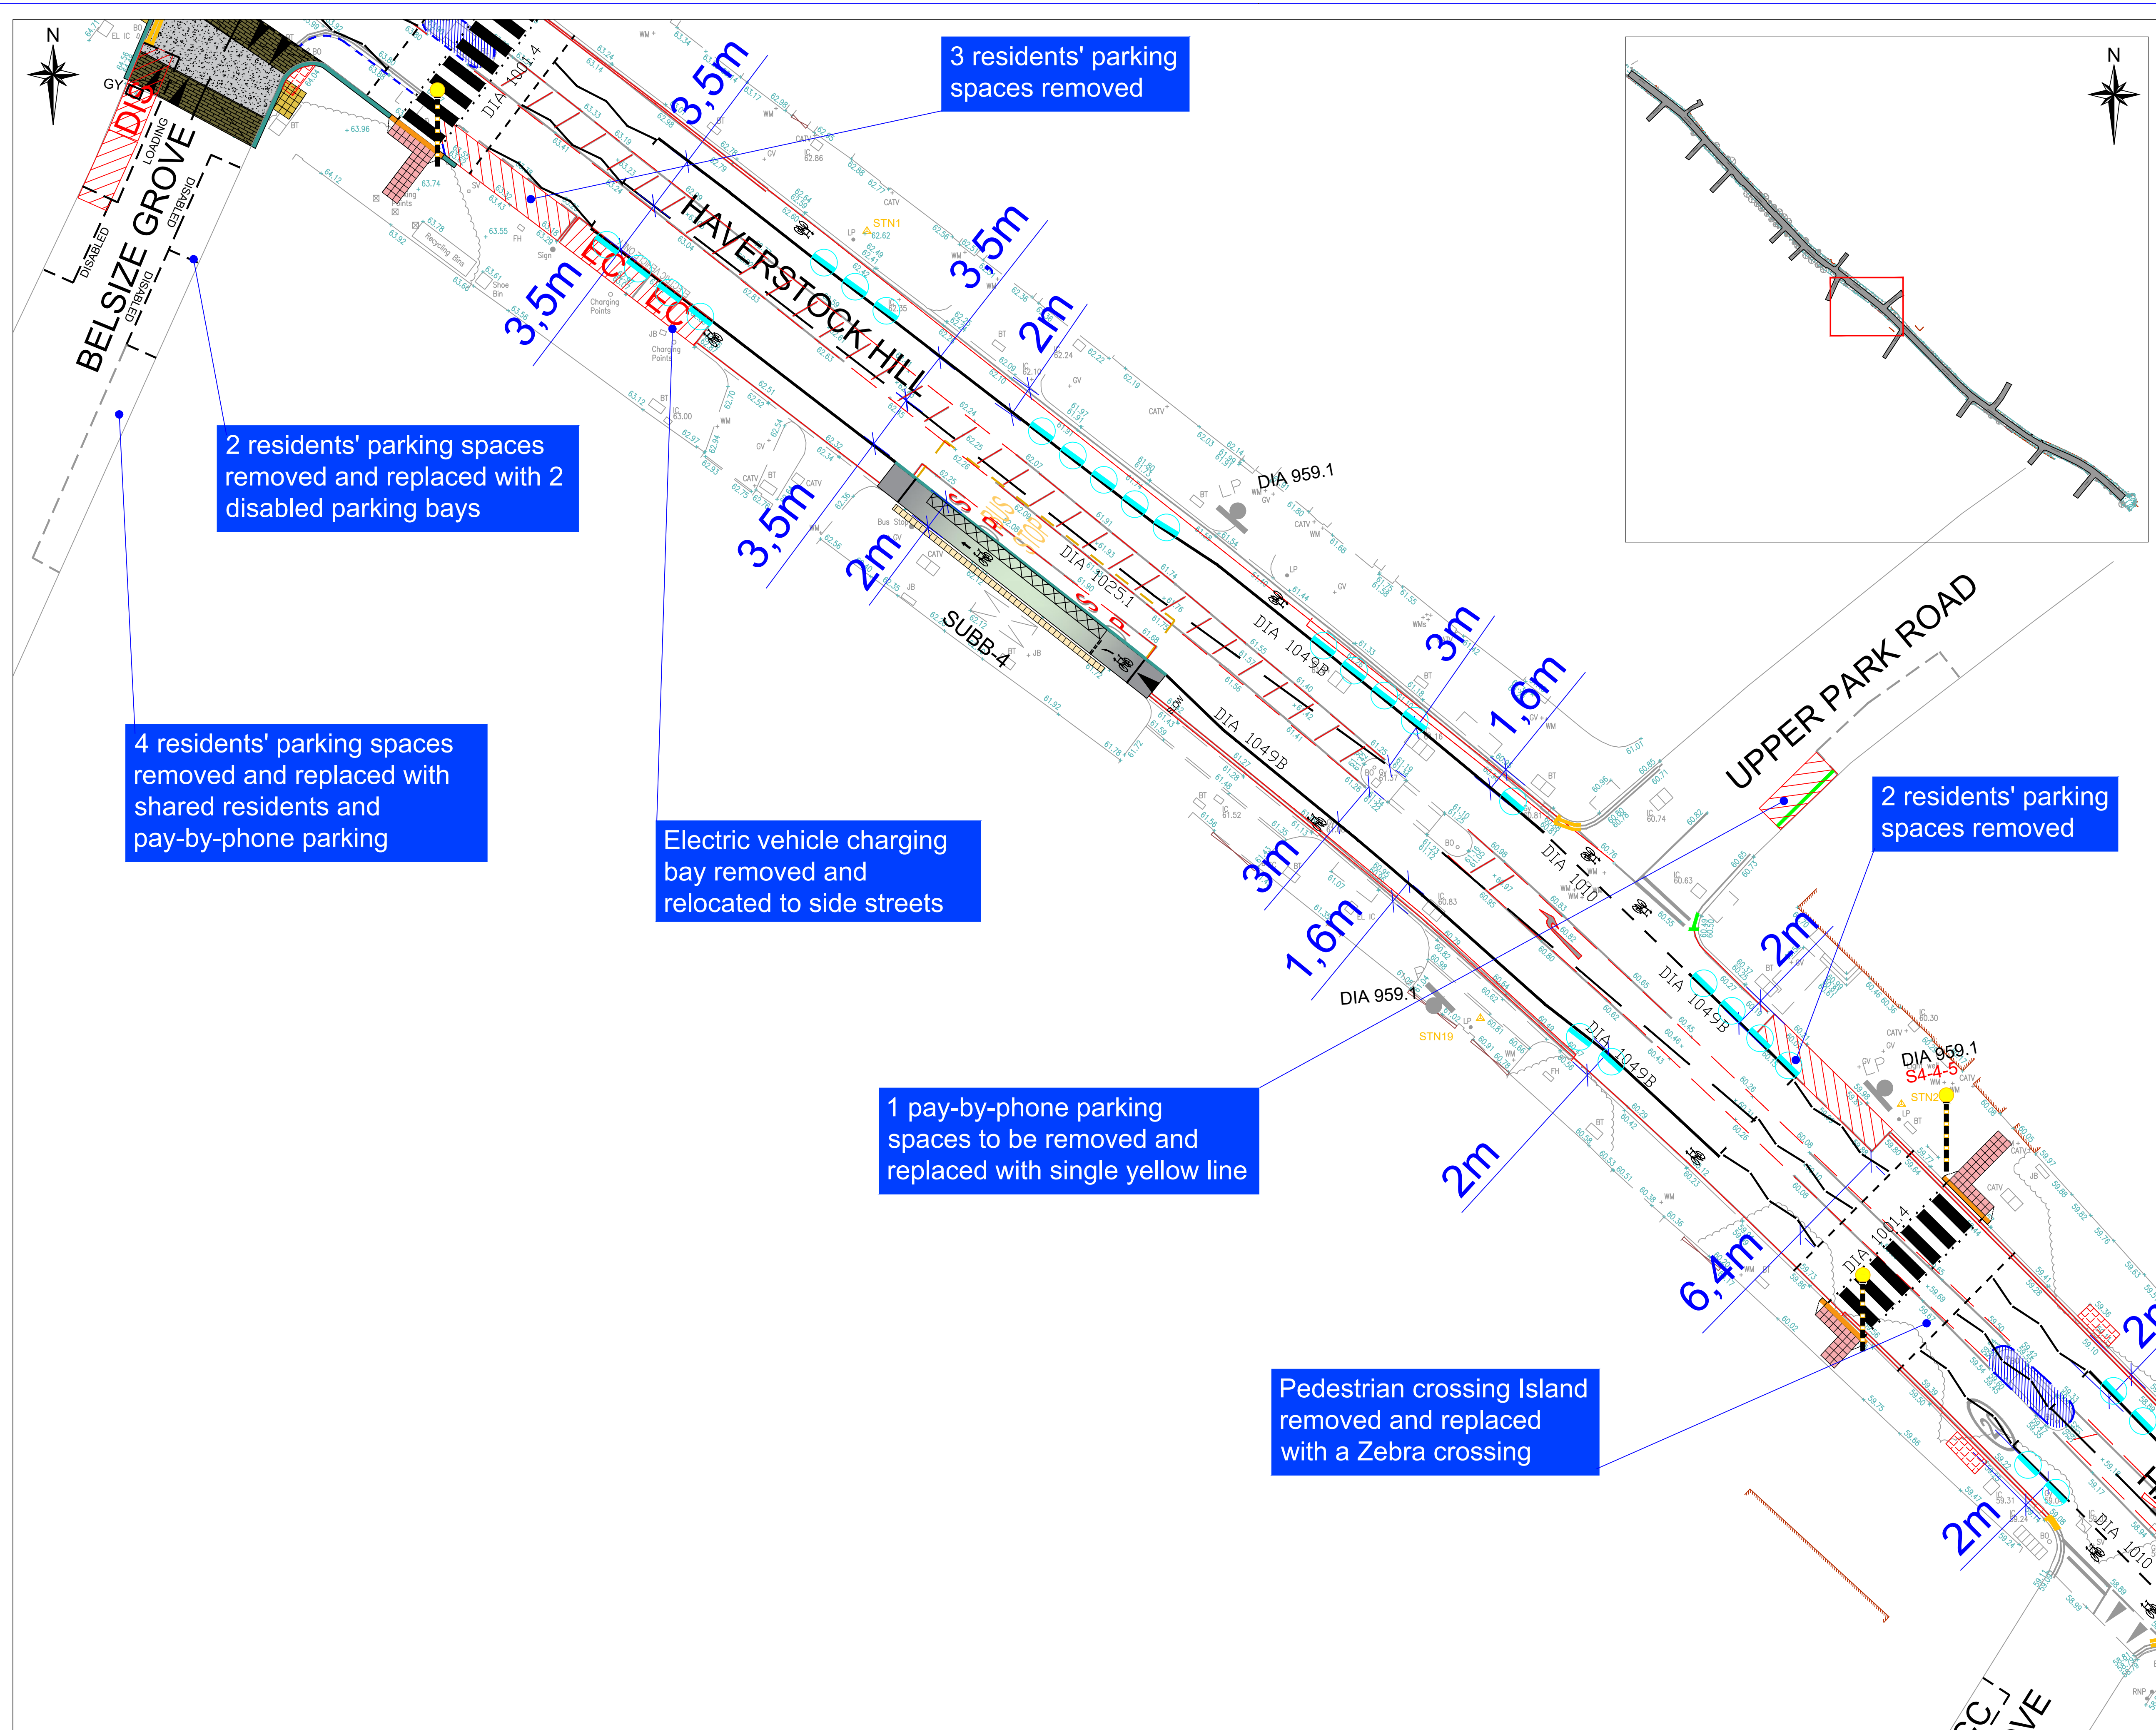

- KEY:**
- NEW DOUBLE YELLOW LINE MARKING / EXISTING TO BE REFRESHED
 - ROAD MARKINGS TO BE REMOVED
 - EXISTING LAYOUT TO BE RETAINED
 - TRAFFIC ISLAND TO BE REMOVED
 - PARKING BAY REMOVED
 - ELECTRIC VEHICLE CHARGING BAY REMOVED
 - CAR CLUB BAYS REMOVED
 - DISABLED BAYS REMOVED
 - DIS
 - NEW DISABLED BAY 3HRS MAX STAY
 - NEW OR REVISED PARKING BAY
 - NEW ELECTRIC VEHICLE CHARGING BAY
 - NEW CAR CLUB BAY
 - KERBS TO BE REMOVED
 - NEW KERBS LINE
 - NEW DROPPED KERB
 - NEW ARTIFICIAL STONE PAVING
 - NEW MASTIC ASPHALT PAVING
 - NEW PAVING BLOCKS
 - NEW BUFF TACTILE PAVING
 - NEW RED TACTILE PAVING
 - MANHOLE COVER REPLACED TO MATCH NEW USE
 - MANHOLE DROPPED TO MATCH SURROUNDING LEVELS AND COVER REPLACED TO MATCH NEW USE
 - MANHOLE RAISED TO MATCH SURROUNDING LEVELS AND COVER RETAINED
 - TACTILE PAVING TO BE REMOVED
 - NEW 247 MANDATORY CYCLE LANES AND CYCLE LOGOS (DIA 1057)
 - DIA 0000
 - INSTALL TRAFFIC SIGNS REGULATION AND GENERAL DIRECTION DIAGRAM NUMBER
 - REMOVE TRAFFIC SIGNS REGULATION AND GENERAL DIRECTION DIAGRAM NUMBER TO STORAGE
 - EXISTING LAMP COLUMN AND NEW SIGNS
 - NEW POST AND SIGN
 - EXISTING POST AND SIGN
 - NEW SHARED USE BUS BOARDERS (SUBB) WITH TACTILE PAVING
 - NEW ZEBRA CROSSING (DIA 1001.4)
 - WAND ORCAS INSTALLED @ 2.5M SPACING
 - NEW BELISHA BEACON

- NOTES:**
- ALL ITEMS SHOWN RED ARE TO BE REMOVED, GREY ARE TO BE MAINTAINED AND BLACK ARE TO BE INSTALLED AS PART OF WORK
 - THIS DRAWING IS BASED ON CD SURVEYS LTD TOPOGRAPHICAL SURVEY DRAWING NO. 2008046 - HAVERSTOCK HILL, LONDON FINAL
 - THIS AND ALL DRAWINGS ARE TO BE READ IN CONJUNCTION WITH THE SPECIFICATION FOR HIGHWAY WORKS AND OTHER SCHEME DRAWINGS
 - IF IN DOUBT OF ANY ASPECT OF THE DESIGN REFER TO THE LEAD DESIGNER FOR CLARIFICATION
 - EXISTING ACCESSES SHOULD BE MAINTAINED AT ALL TIMES AND NOT OBSTRUCTED UNLESS WITH PRIOR CONSENT FROM AFFECTED PARTIES
 - A MINIMUM FOOTWAY WIDTH OF 1.5M (OR AN ABSOLUTE MINIMUM OF 1M, OVER A MAXIMUM LENGTH OF 6M) SHOULD BE MAINTAINED DURING SITE CLEARANCE
 - ALL EXISTING LIGHTING COLUMNS, ILLUMINATED BOLLARDS OR ROAD SIGNS ARE TO BE DISCONNECTED AND MADE SAFE BEFORE REMOVALS
 - CONTRACTOR TO ENSURE TREE ROOTS ARE PROTECTED DURING EXCAVATION WORKS AROUND TREES
 - WAND ORCAS ARE TO BE POSITIONED ON THE INSIDE OF MANDATORY CYCLE LANE MARKINGS
 - MANDATORY CYCLE LANE DIMENSIONS ARE FROM THE KERB FACE TO THE OUTSIDE OF THE MANDATORY WHITE LINE MARKINGS

A	WH	23/06/20	Amendments to notes and drawing
B	WH	19/08/20	Amendments to notes and drawing
C	WH	09/10/20	Amendments to crossings and lanes
D	WH	26/10/20	Amendments to parking and loading

Rev	By	Date	Amendments
-----	----	------	------------




Design Team
Transport Strategy Service
London Borough of Camden
5 Pancras Square
Tel 020 7974 5551, Fax 020 7974 6952
DX 2106 Euston, Minicom 020 7974 6866

Project
**CYCLE POP-UP SCHEME
HAVERSTOCK HILL**

Drawing Title
GENERAL ARRANGEMENTS

Scale 1 : 200 @ A1	Date JUNE 2020
Drawn By WH	File Ref T:\Cap_Sm\2019\20/CYCLE POP-UP/Haverstock Hill
Checked By SS	Dwg Name CYCLE POP-UP
Drawing Location -	
Drawing Number SSF/000-CS-100-01-005	Rev. D

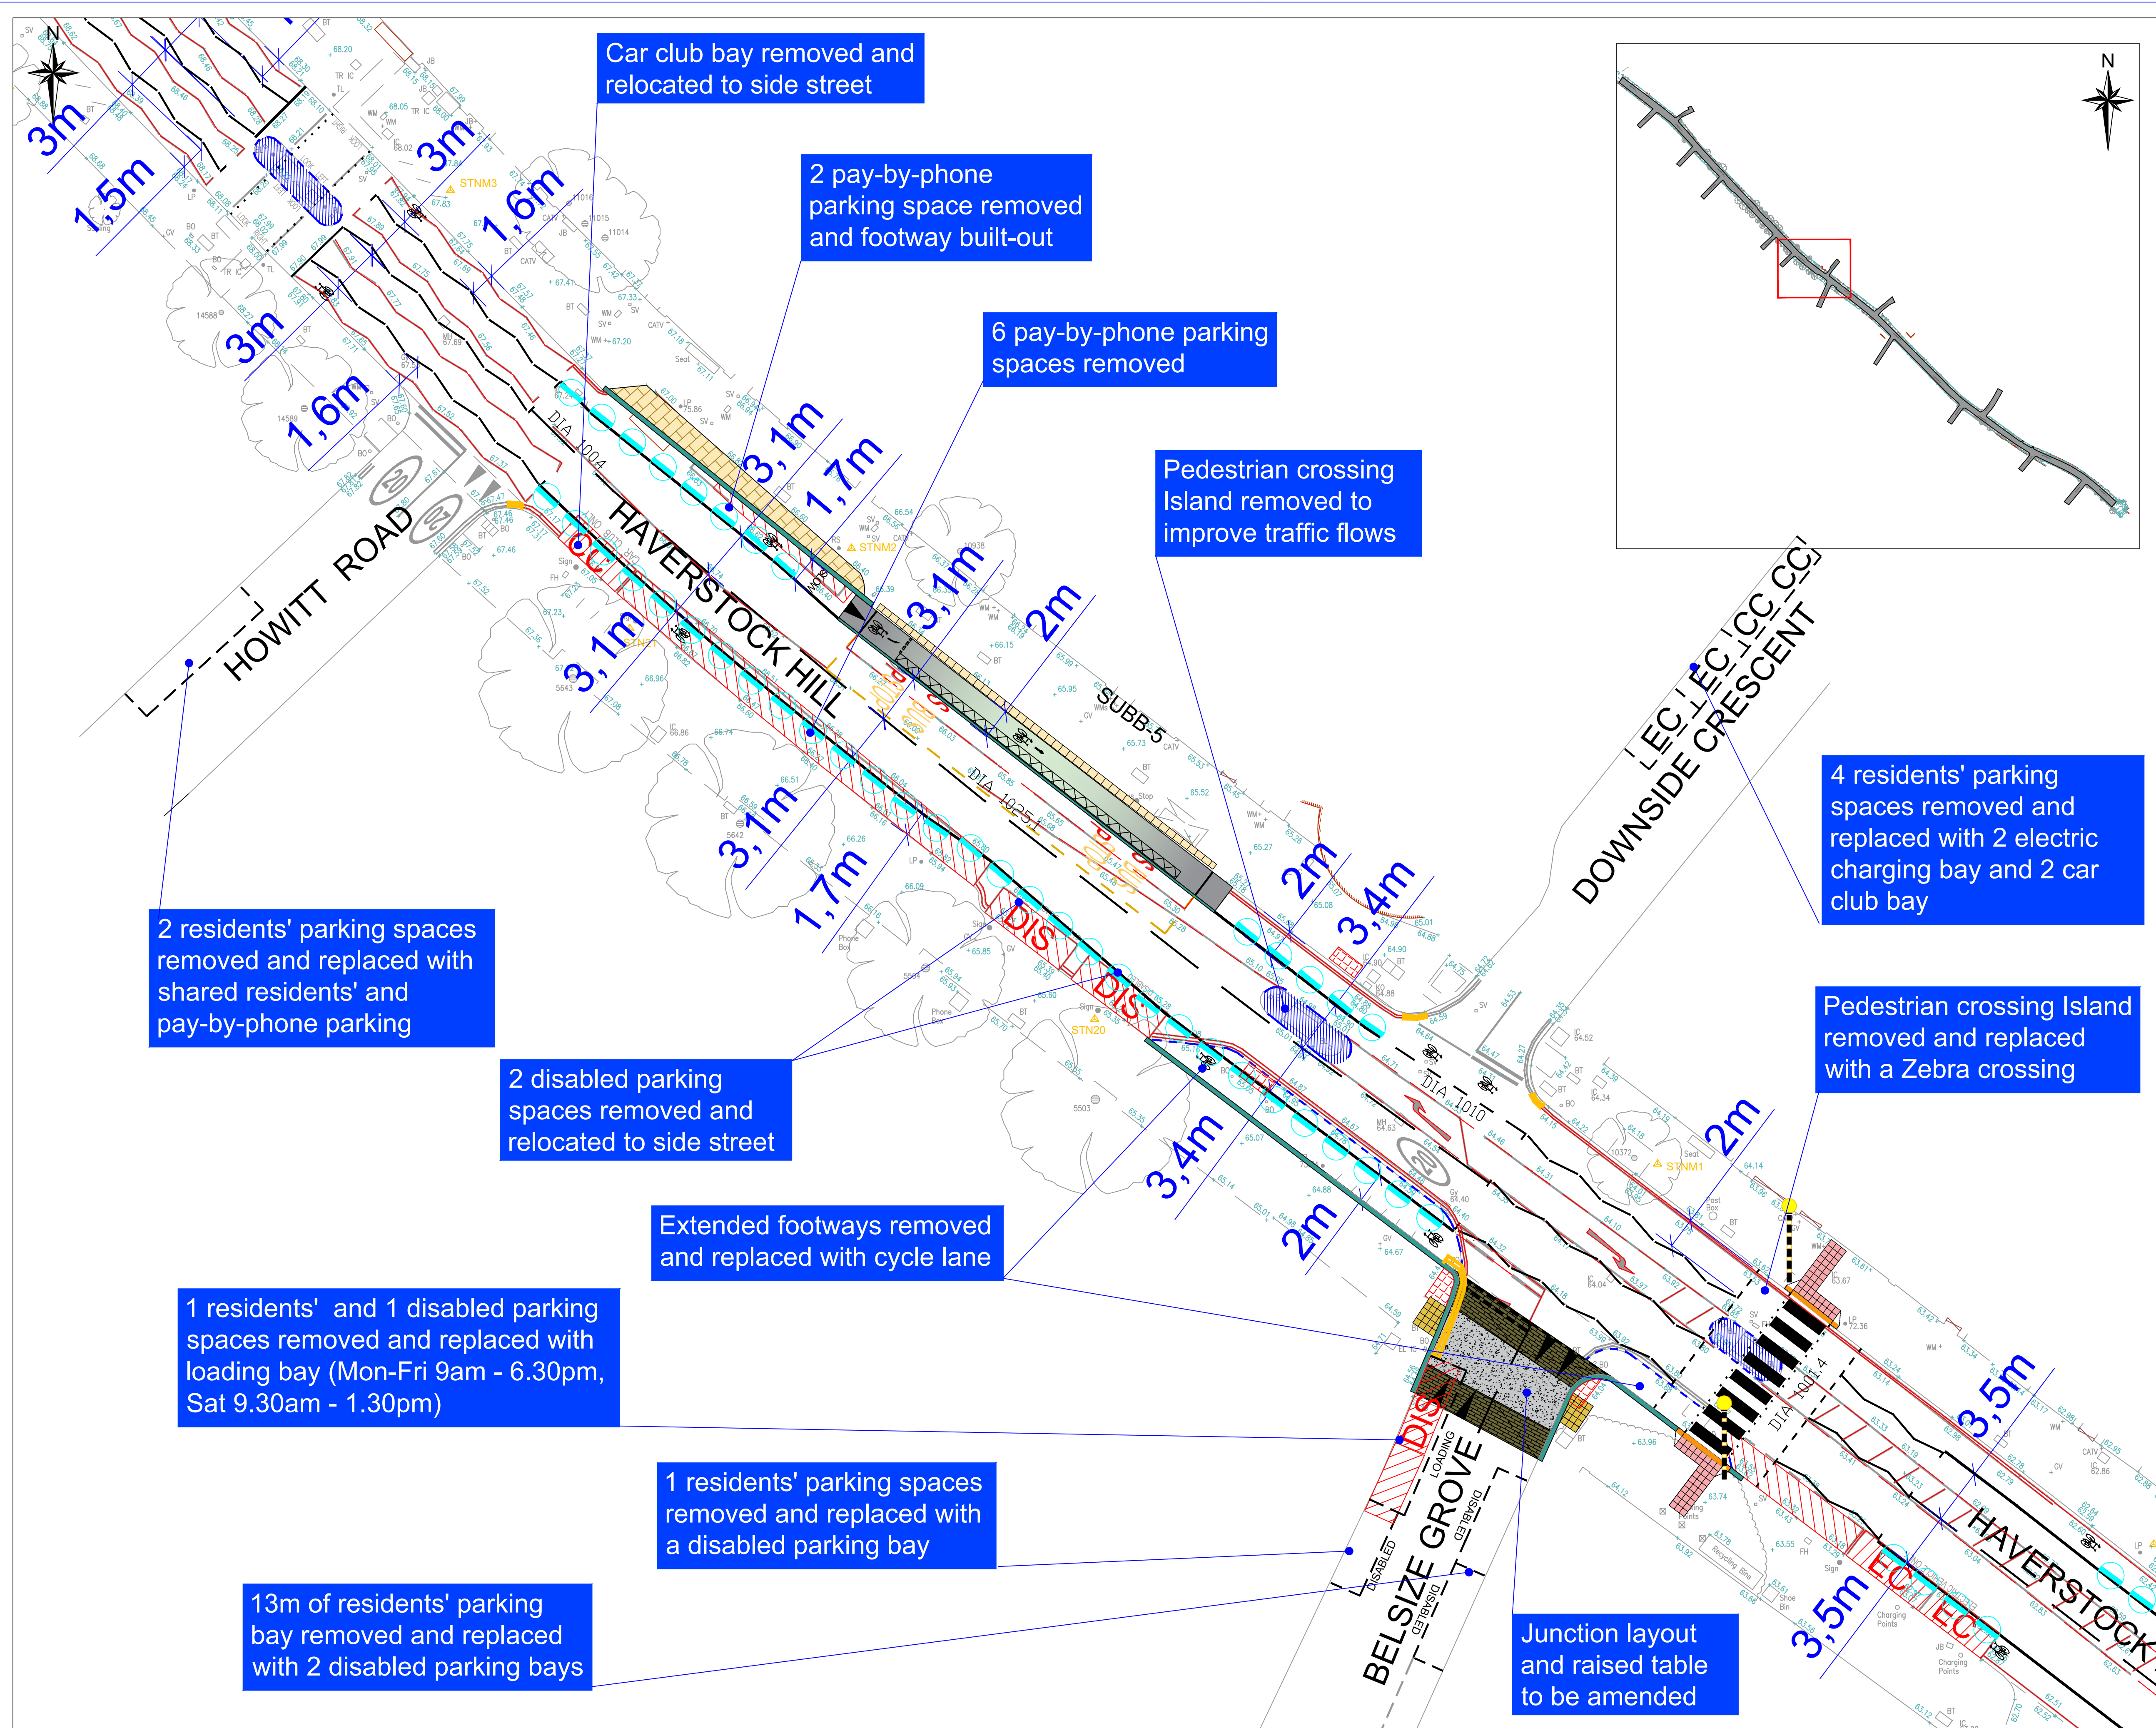

KEY:

- NEW DOUBLE YELLOW LINE MARKING / EXISTING TO BE REFRESHED
- ROAD MARKINGS TO BE REMOVED
- EXISTING LAYOUT TO BE RETAINED
- TRAFFIC ISLAND TO BE REMOVED
- PARKING BAY REMOVED
- ELECTRIC VEHICLE CHARGING BAY REMOVED
- CAR CLUB BAYS REMOVED
- DISABLED BAYS REMOVED
- NEW DISABLED BAY 3HRS MAX STAY
- NEW OR REVISED PARKING BAY
- NEW ELECTRIC VEHICLE CHARGING BAY
- NEW CAR CLUB BAY
- KERBS TO BE REMOVED
- NEW KERBS LINE
- NEW DROPPED KERB
- NEW ARTIFICIAL STONE PAVING
- NEW MASTIC ASPHALT PAVING
- NEW PAVING BLOCKS
- NEW BUFF TACTILE PAVING
- NEW RED TACTILE PAVING
- MANHOLE COVER REPLACED TO MATCH NEW USE
- MANHOLE DROPPED TO MATCH SURROUNDING LEVELS AND COVER REPLACED TO MATCH NEW USE
- MANHOLE RAISED TO MATCH SURROUNDING LEVELS AND COVER RETAINED
- TACTILE PAVING TO BE REMOVED
- NEW 24/7 MANDATORY CYCLE LANES AND CYCLE LOGOS (DIA 1007)
- INSTALL TRAFFIC SIGNS REGULATION AND GENERAL DIRECTION DIAGRAM NUMBER
- REMOVE TRAFFIC SIGNS REGULATION AND GENERAL DIRECTION DIAGRAM NUMBER TO STORAGE
- EXISTING LAMP COLUMN AND NEW SIGNS
- NEW POST AND SIGN
- EXISTING POST AND SIGN
- NEW SHARED USE BUS BOARDERS (SUBB) WITH TACTILE PAVING
- NEW ZEBRA CROSSING (DIA 1001.4)
- WAND ORCAS INSTALLED @ 2.5M SPACING
- NEW BELISHA BEACON

- NOTES:**
- ALL ITEMS SHOWN RED ARE TO BE REMOVED, GREY ARE TO BE MAINTAINED AND BLACK ARE TO BE INSTALLED AS PART OF WORK
 - THIS DRAWING IS BASED ON CD SURVEYS LTD TOPOGRAPHICAL SURVEY DRAWING NO. 2008046 - HAVERSTOCK HILL, LONDON FINAL
 - THIS AND ALL DRAWINGS ARE TO BE READ IN CONJUNCTION WITH THE SPECIFICATION FOR HIGHWAY WORKS AND OTHER SCHEME DRAWINGS
 - IF IN DOUBT OF ANY ASPECT OF THE DESIGN REFER TO THE LEAD DESIGNER FOR CLARIFICATION
 - EXISTING ACCESSES SHOULD BE MAINTAINED AT ALL TIMES AND NOT OBSTRUCTED UNLESS WITH PRIOR CONSENT FROM AFFECTED PARTIES
 - A MINIMUM FOOTWAY WIDTH OF 1.5M (OR AN ABSOLUTE MINIMUM OF 1M, OVER A MAXIMUM LENGTH OF 6M) SHOULD BE MAINTAINED DURING SITE CLEARANCE
 - ALL EXISTING LIGHTING COLUMNS, ILLUMINATED BOLLARDS OR ROAD SIGNS ARE TO BE DISCONNECTED AND MADE SAFE BEFORE REMOVALS
 - CONTRACTOR TO ENSURE TREE ROOTS ARE PROTECTED DURING EXCAVATION WORKS AROUND TREES
 - WAND ORCAS ARE TO BE POSITIONED ON THE INSIDE OF MANDATORY CYCLE LANE MARKINGS
 - MANDATORY CYCLE LANE DIMENSIONS ARE FROM THE KERB FACE TO THE OUTSIDE OF THE MANDATORY WHITE LINE MARKINGS

A	WH	23/06/20	Amendments to notes and drawing
B	WH	19/08/20	Amendments to notes and drawing
C	WH	09/10/20	Amendments to crossings and lanes
D	WH	26/10/20	Amendments to parking and loading

Rev	By	Date	Amendments
-----	----	------	------------



Camden
Design Team
Transport Strategy Service
London Borough of Camden
5 Pancras Square
Tel 020 7974 5551, Fax 020 7974 6952
DX 2106 Euston, Minicom 020 7974 6866

Project
**CYCLE POP-UP SCHEME
HAVERSTOCK HILL**

Drawing Title
GENERAL ARRANGEMENTS

Scale 1 : 200 @ A1	Date JUNE 2020
Drawn By WH	File Ref T:\Cap_Sm2019\2019\Cycle Pop-Up\Haverstock Hill
Checked By SS	Dwg Name CYCLE POP-UP

Drawing Location -	Drawing Number SSF/000-CS-100-01-006	Rev. D
-----------------------	---	-----------

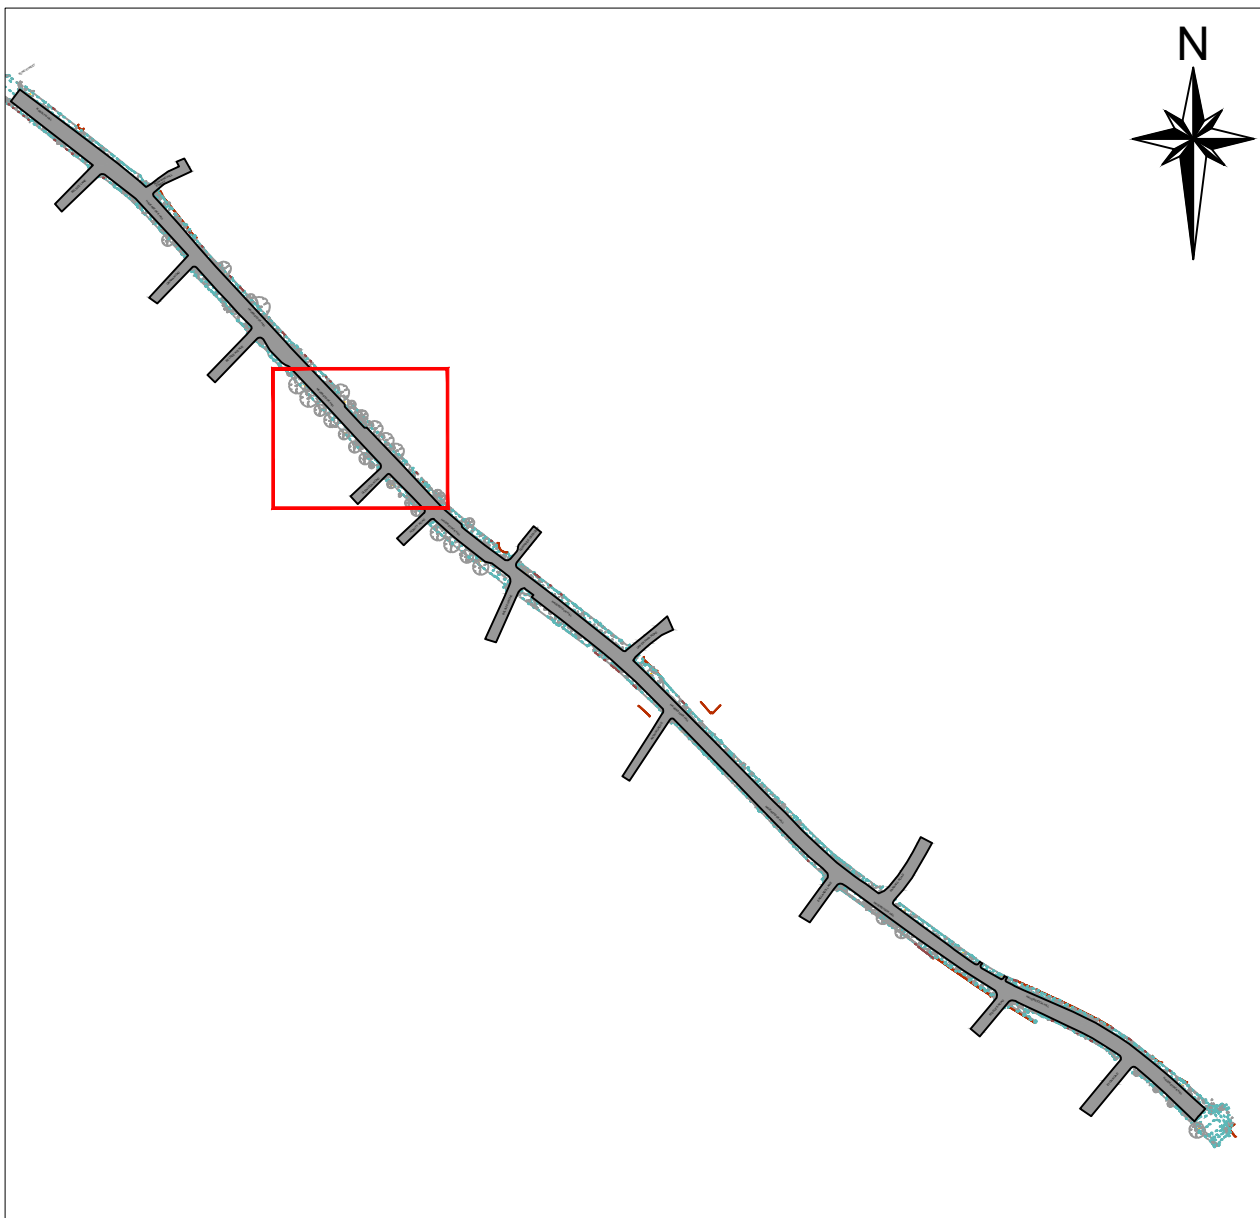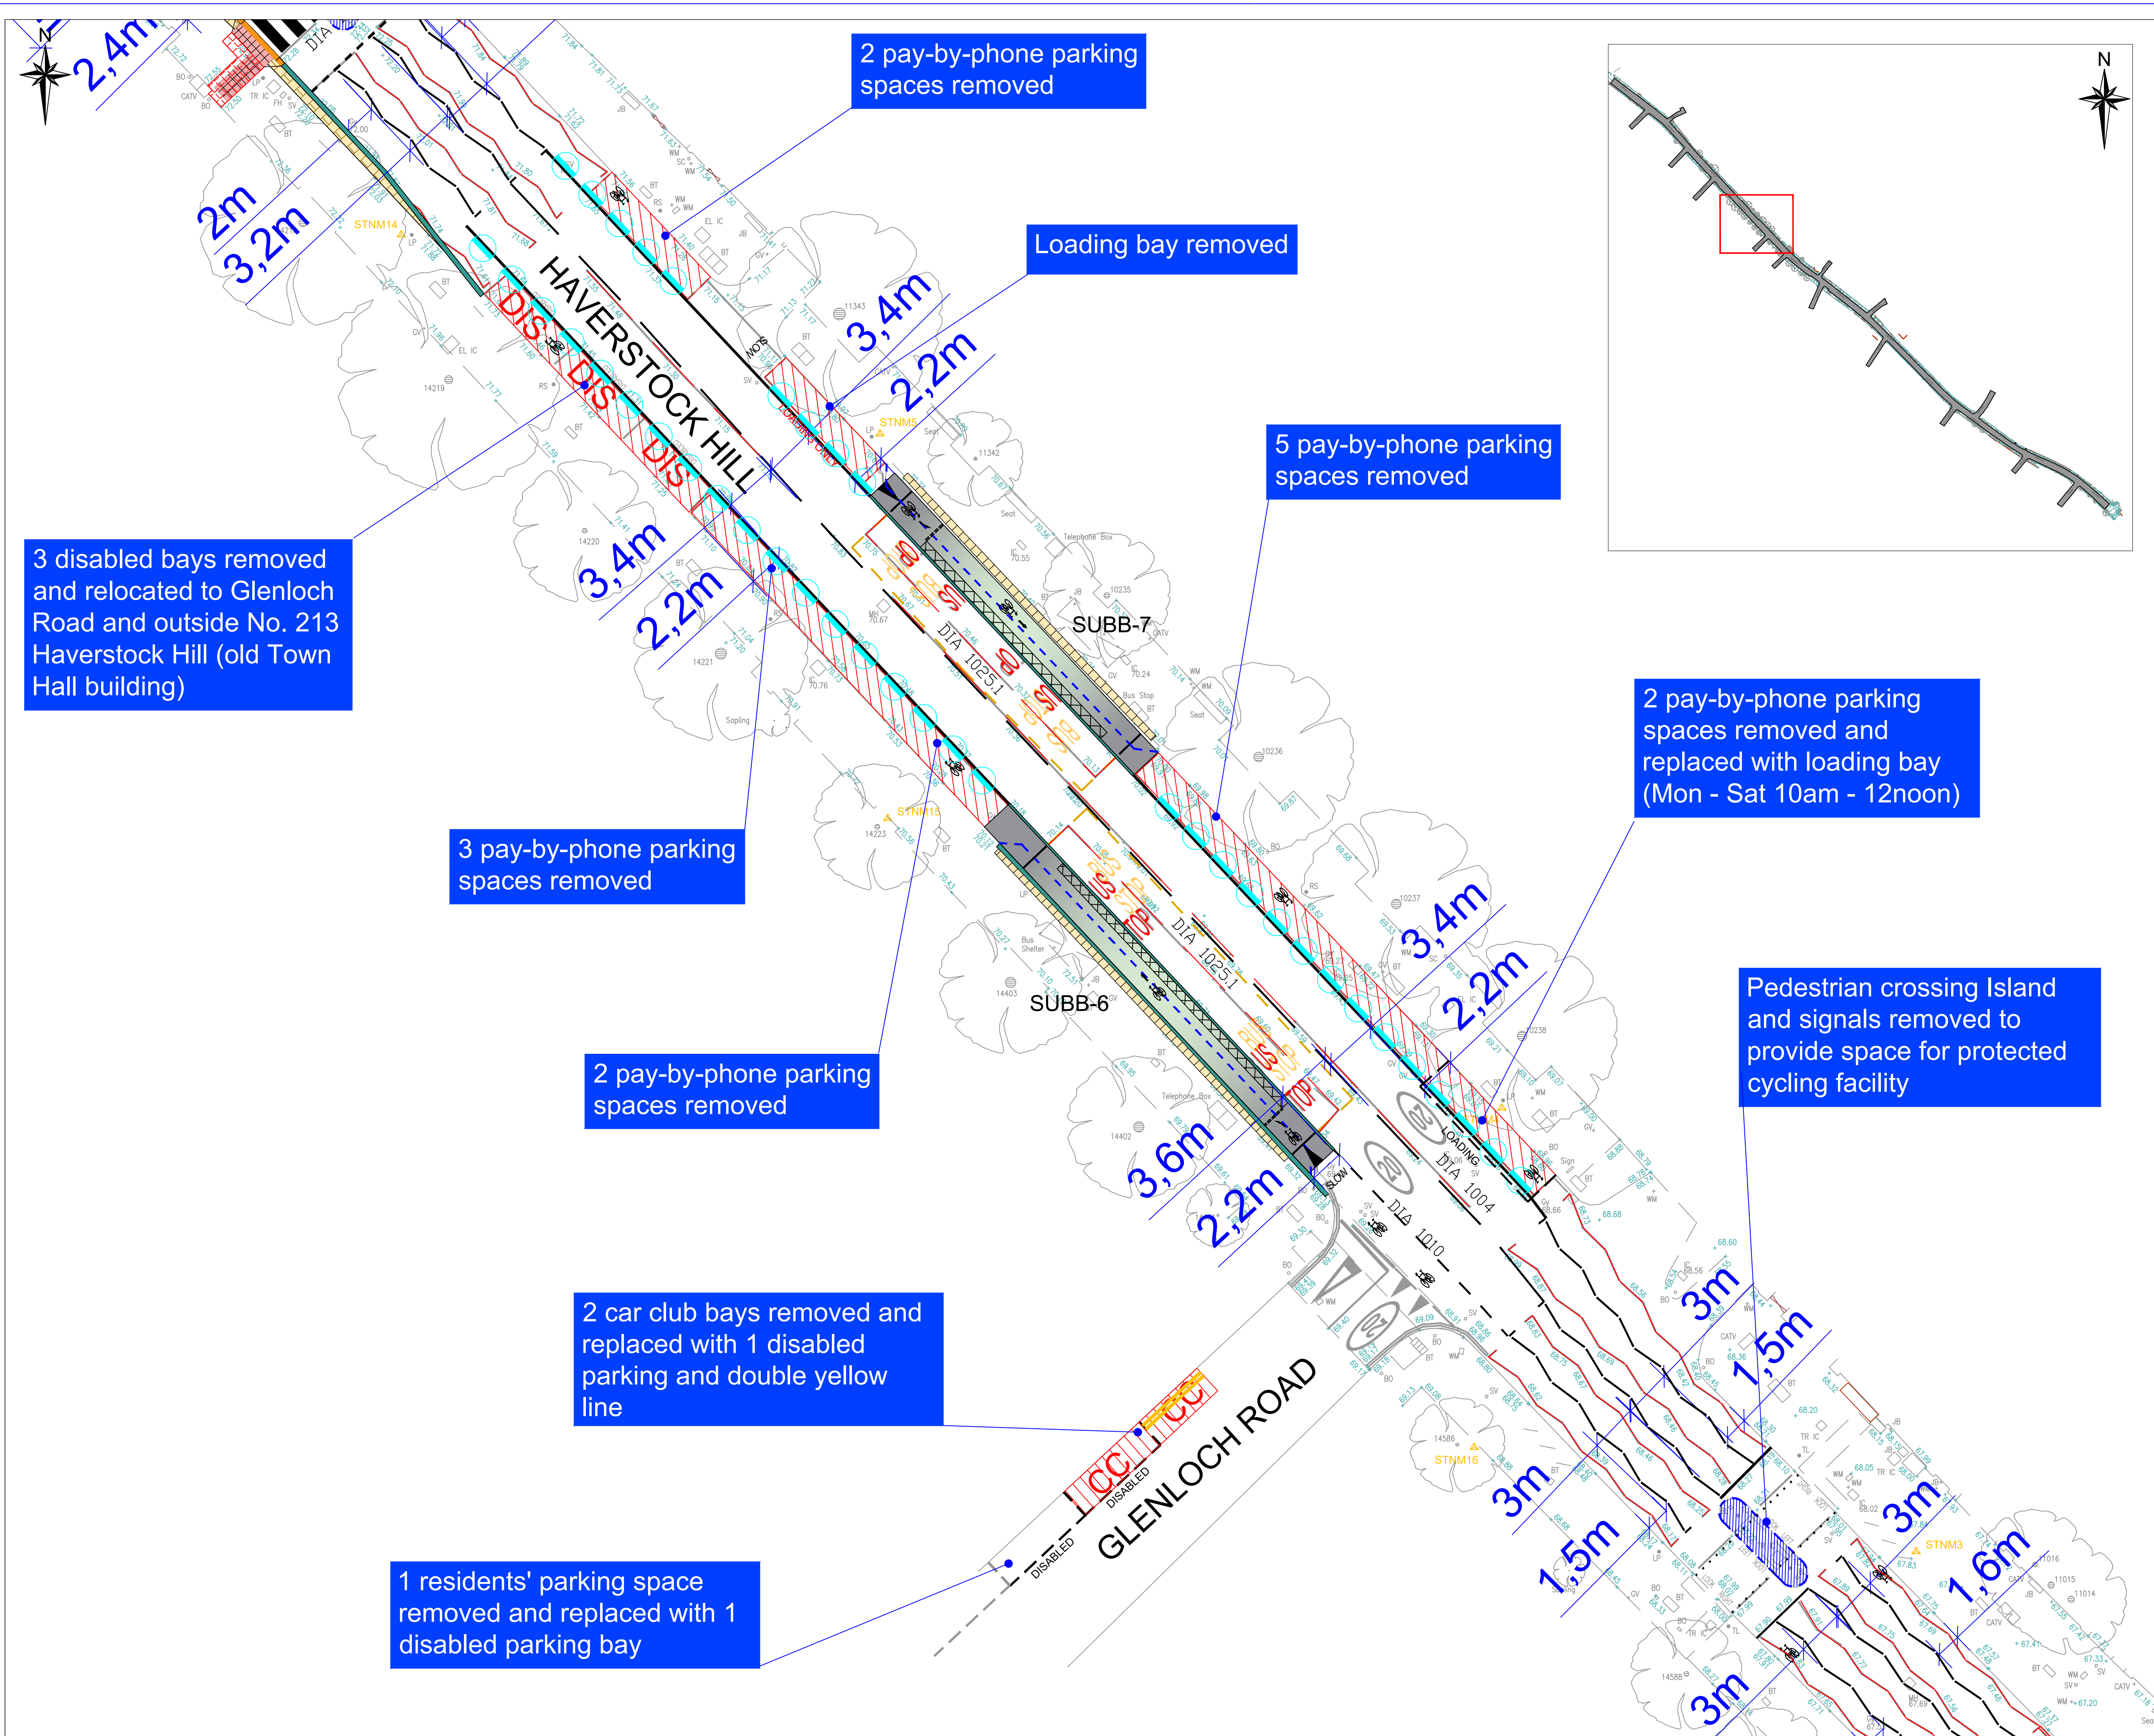

- KEY:**
- NEW DOUBLE YELLOW LINE MARKING / EXISTING TO BE REFRESHED
 - ROAD MARKINGS TO BE REMOVED
 - EXISTING LAYOUT TO BE RETAINED
 - TRAFFIC ISLAND TO BE REMOVED
 - PARKING BAY REMOVED
 - ELECTRIC VEHICLE CHARGING BAY REMOVED
 - CAR CLUB BAYS REMOVED
 - DISABLED BAYS REMOVED
 - DIS
 - NEW DISABLED BAY 3HRS MAX STAY
 - NEW OR REVISED PARKING BAY
 - NEW ELECTRIC VEHICLE CHARGING BAY
 - NEW CAR CLUB BAY
 - KERBS TO BE REMOVED
 - NEW KERBS LINE
 - NEW DROPPED KERB
 - NEW ARTIFICIAL STONE PAVING
 - NEW MASTIC ASPHALT PAVING
 - NEW PAVING BLOCKS
 - NEW BUFF TACTILE PAVING
 - NEW RED TACTILE PAVING
 - MANHOLE COVER REPLACED TO MATCH NEW USE
 - MANHOLE DROPPED TO MATCH SURROUNDING LEVELS AND COVER REPLACED TO MATCH NEW USE
 - MANHOLE RAISED TO MATCH SURROUNDING LEVELS AND COVER RETAINED
 - TACTILE PAVING TO BE REMOVED
 - NEW 24/7 MANDATORY CYCLE LANES AND CYCLE LAYOUTS (DIA 1007)
 - INSTALL TRAFFIC SIGNS REGULATION AND GENERAL DIRECTION DIAGRAM NUMBER
 - REMOVE TRAFFIC SIGNS REGULATION AND GENERAL DIRECTION DIAGRAM NUMBER TO STORAGE
 - EXISTING LAMP COLUMN AND NEW SIGNS
 - NEW POST AND SIGN
 - EXISTING POST AND SIGN
 - NEW SHARED USE BUS BOARDERS (SUBB) WITH TACTILE PAVING
 - NEW ZEBRA CROSSING (DIA 1001.4)
 - WAND ORCAS INSTALLED @ 2.5M SPACING
 - NEW BELISHA BEACON

- NOTES:**
- ALL ITEMS SHOWN RED ARE TO BE REMOVED, GREY ARE TO BE MAINTAINED AND BLACK ARE TO BE INSTALLED AS PART OF WORK
 - THIS DRAWING IS BASED ON CD SURVEYS LTD TOPOGRAPHICAL SURVEY DRAWING NO. 2008045 - HAVERSTOCK HILL, LONDON FINAL
 - THIS AND ALL DRAWINGS ARE TO BE READ IN CONJUNCTION WITH THE SPECIFICATION FOR HIGHWAY WORKS AND OTHER SCHEME DRAWINGS
 - IF IN DOUBT OF ANY ASPECT OF THE DESIGN REFER TO THE LEAD DESIGNER FOR CLARIFICATION
 - EXISTING ACCESSES SHOULD BE MAINTAINED AT ALL TIMES AND NOT OBSTRUCTED UNLESS WITH PRIOR CONSENT FROM AFFECTED PARTIES
 - A MINIMUM FOOTWAY WIDTH OF 1.5M (OR AN ABSOLUTE MINIMUM OF 1M, OVER A MAXIMUM LENGTH OF 6M) SHOULD BE MAINTAINED DURING SITE CLEARANCE
 - ALL EXISTING LIGHTING COLUMNS, ILLUMINATED BOLLARDS OR ROAD SIGNS ARE TO BE DISCONNECTED AND MADE SAFE BEFORE REMOVALS
 - CONTRACTOR TO ENSURE TREE ROOTS ARE PROTECTED DURING EXCAVATION WORKS AROUND TREES
 - WAND ORCAS ARE TO BE POSITIONED ON THE INSIDE OF MANDATORY CYCLE LANE MARKINGS
 - MANDATORY CYCLE LANE DIMENSIONS ARE FROM THE KERB FACE TO THE OUTSIDE OF THE MANDATORY WHITE LINE MARKINGS

A	WH	23/06/20	Amendments to notes and drawing
B	WH	19/08/20	Amendments to notes and drawing
C	WH	09/10/20	Amendments to crossings and lanes
D	WH	26/10/20	Amendments to parking and loading

Rev	By	Date	Amendments
-----	----	------	------------




Design Team
Transport Strategy Service
London Borough of Camden
5 Pancras Square
Tel 020 7974 5551, Fax 020 7974 6952
DX 2106 Euston, Minicom 020 7974 6866

Project
**CYCLE POP-UP SCHEME
HAVERSTOCK HILL**

Drawing Title
GENERAL ARRANGEMENTS

Scale 1 : 200 @ A1	Date JUNE 2020
Drawn By WH	File Ref T:\Cap_Sm2019\2020\CLE POP-UP\Haverstock Hill
Checked By SH	Dwg Name CYCLE POP-UP

Drawing Location -	Drawing Number SSF/000-CS-100-01-007	Rev. D
-----------------------	--	------------------

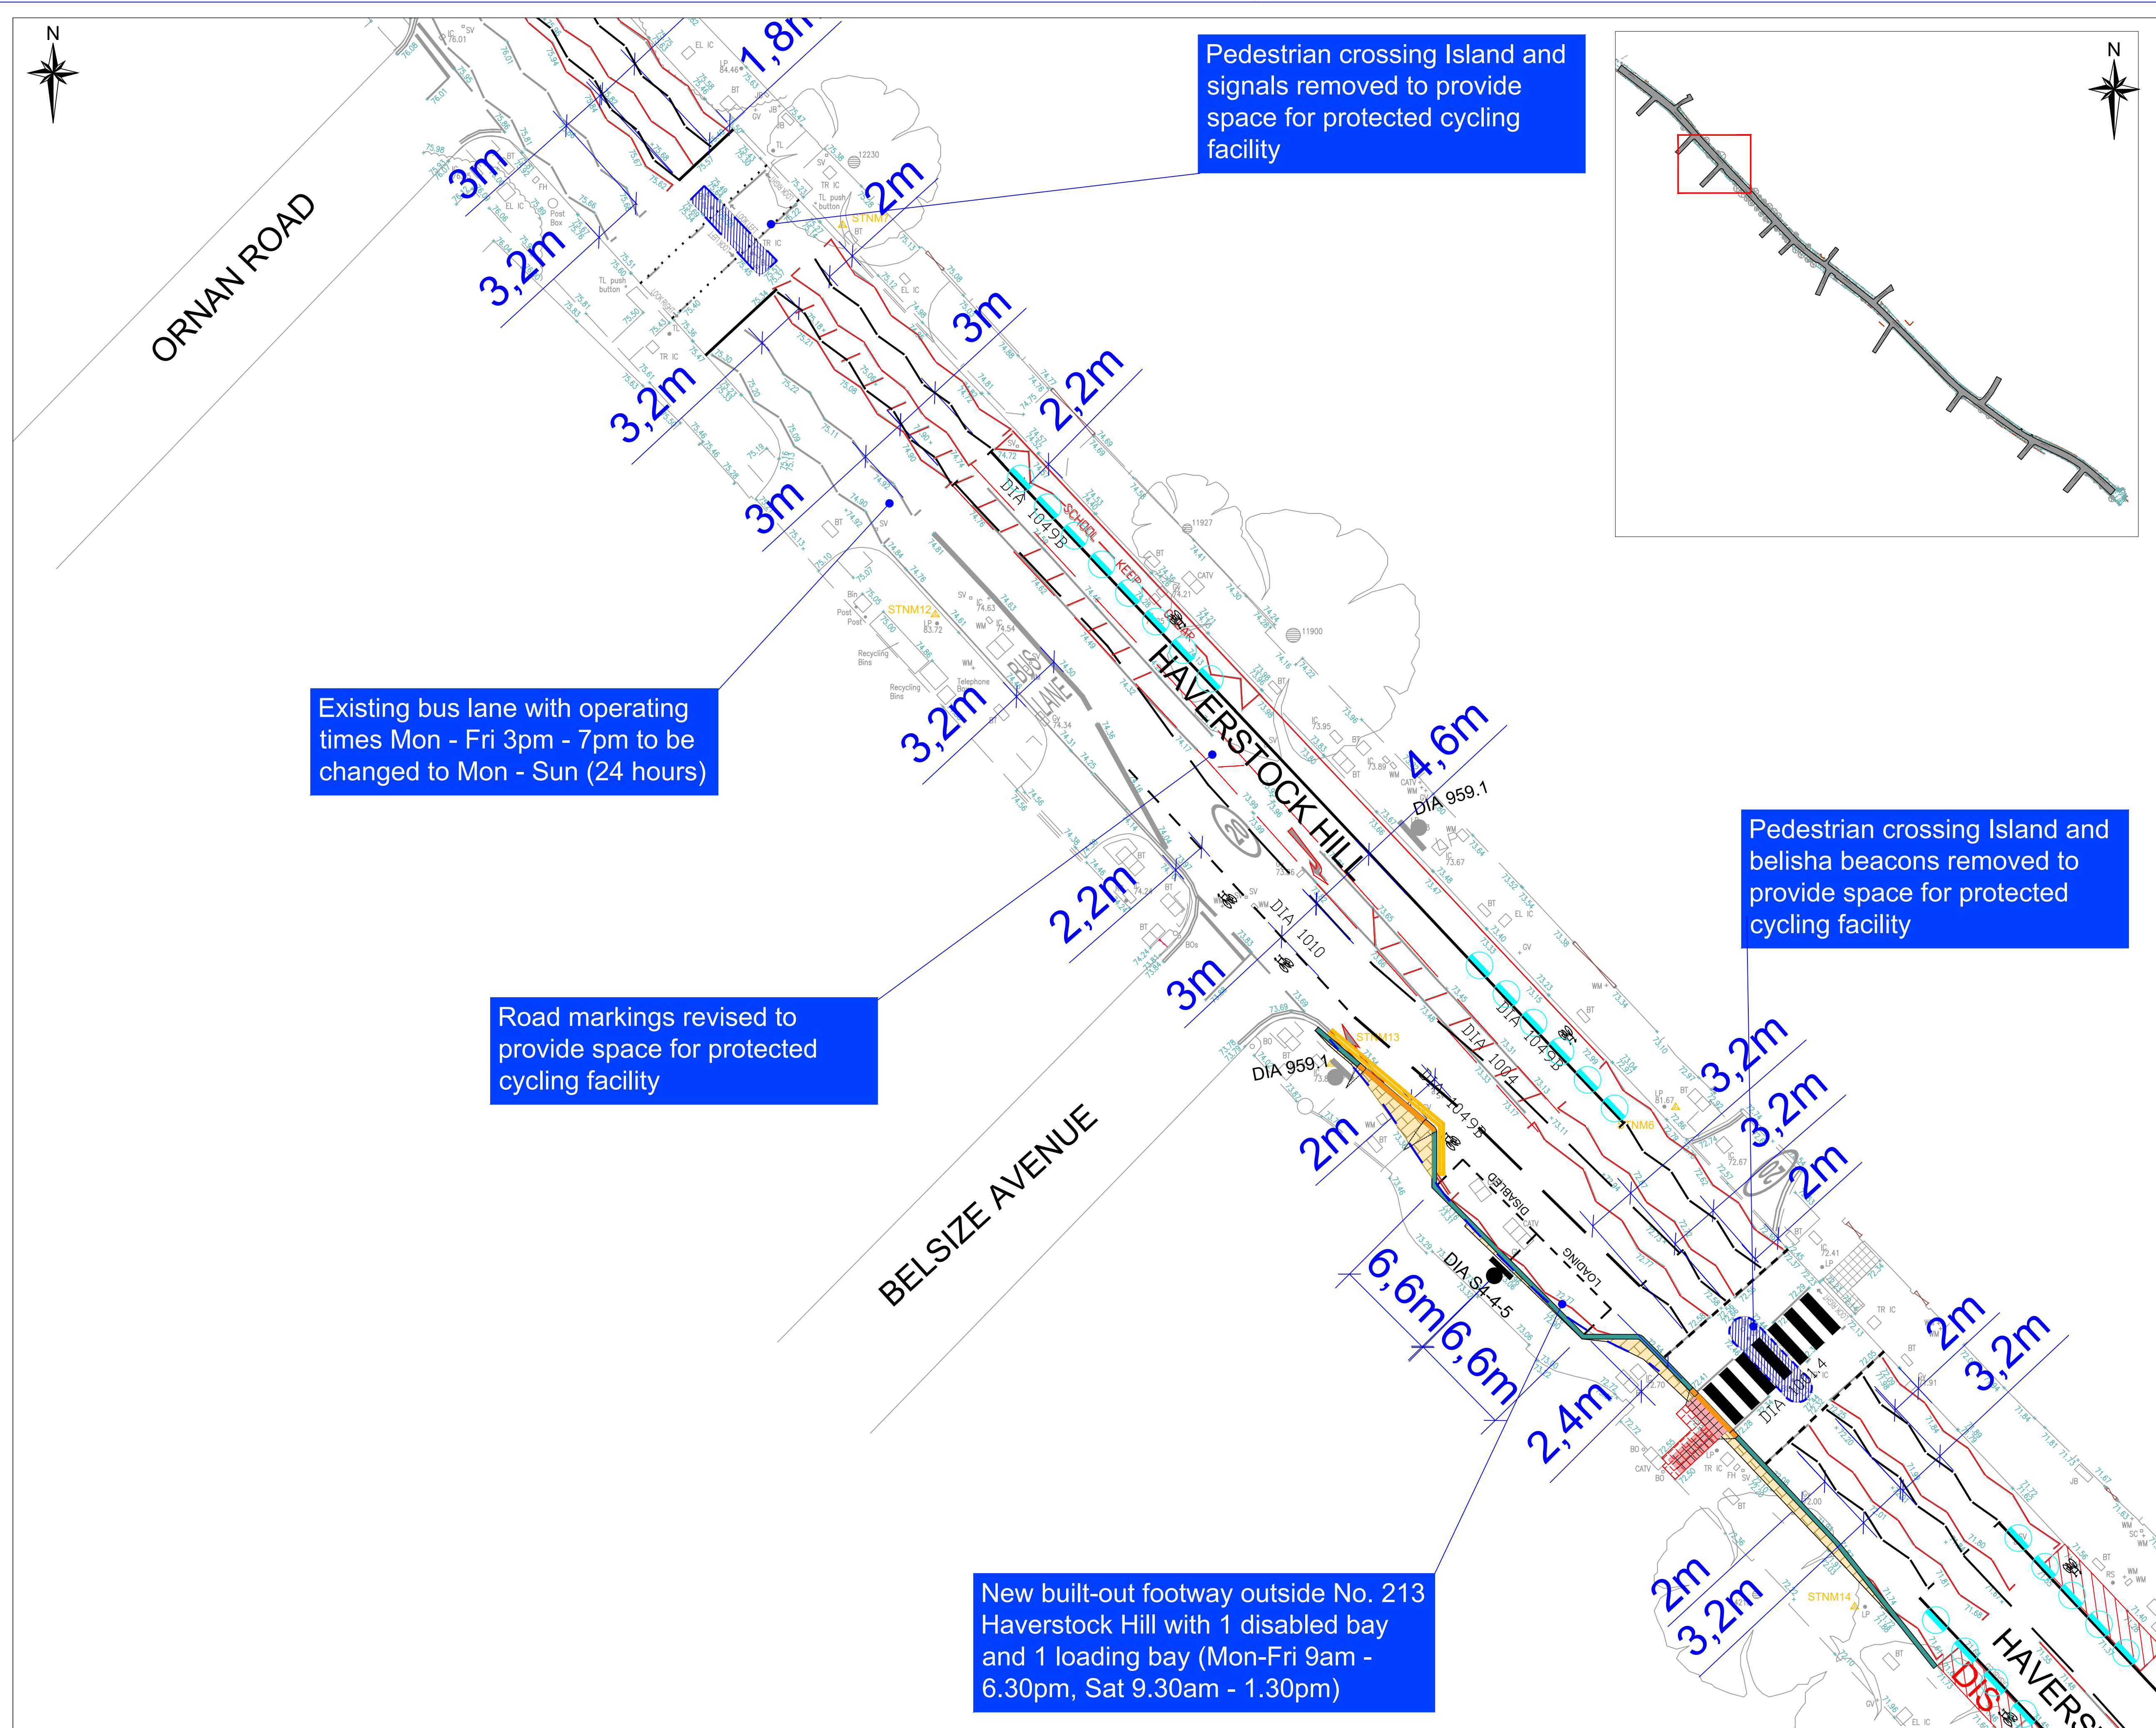

KEY:	
	NEW DOUBLE YELLOW LINE MARKING / EXISTING TO BE REFRESHED
	ROAD MARKINGS TO BE REMOVED
	EXISTING LAYOUT TO BE RETAINED
	TRAFFIC ISLAND TO BE REMOVED
	PARKING BAY REMOVED
	ELECTRIC VEHICLE CHARGING BAY REMOVED
	CAR CLUB BAYS REMOVED
	DISABLED BAYS REMOVED
	NEW DISABLED BAY 3HRS MAX STAY
	NEW OR REVISED PARKING BAY
	NEW ELECTRIC VEHICLE CHARGING BAY
	NEW CAR CLUB BAY
	KERBS TO BE REMOVED
	NEW KERBS LINE
	NEW DROPPED KERB
	NEW ARTIFICIAL STONE PAVING
	NEW MASTIC ASPHALT PAVING
	NEW PAVING BLOCKS
	NEW BUFF TACTILE PAVING
	NEW RED TACTILE PAVING
	MANHOLE COVER REPLACED TO MATCH NEW USE
	MANHOLE DROPPED TO MATCH SURROUNDING LEVELS AND COVER REPLACED TO MATCH NEW USE
	MANHOLE RAISED TO MATCH SURROUNDING LEVELS AND COVER RETAINED
	TACTILE PAVING TO BE REMOVED
	NEW 24/7 MANDATORY CYCLE LANES AND CYCLE LOGOS (DIA 1057)
	INSTALL TRAFFIC SIGNS REGULATION AND GENERAL DIRECTION DIAGRAM NUMBER
	REMOVE TRAFFIC SIGNS REGULATION AND GENERAL DIRECTION DIAGRAM NUMBER TO STORAGE
	EXISTING LAMP COLUMN AND NEW SIGNS
	NEW POST AND SIGN
	EXISTING POST AND SIGN
	NEW SHARED USE BUS BOARDERS (SUBB) WITH TACTILE PAVING
	NEW ZEBRA CROSSING (DIA 1001.4)
	WAND ORCAS INSTALLED @ 2.5M SPACING
	NEW BELISHA BEACON

- NOTES:
- ALL ITEMS SHOWN RED ARE TO BE REMOVED, GREY ARE TO BE MAINTAINED AND BLACK ARE TO BE INSTALLED AS PART OF WORK
 - THIS DRAWING IS BASED ON CD SURVEYS LTD TOPOGRAPHICAL SURVEY DRAWING NO. 2008046 - HAVERSTOCK HILL, LONDON FINAL
 - THIS AND ALL DRAWINGS ARE TO BE READ IN CONJUNCTION WITH THE SPECIFICATION FOR HIGHWAY WORKS AND OTHER SCHEME DRAWINGS
 - IF IN DOUBT OF ANY ASPECT OF THE DESIGN REFER TO THE LEAD DESIGNER FOR CLARIFICATION
 - EXISTING ACCESSES SHOULD BE MAINTAINED AT ALL TIMES AND NOT OBSTRUCTED UNLESS WITH PRIOR CONSENT FROM AFFECTED PARTIES
 - A MINIMUM FOOTWAY WIDTH OF 1.5M (OR AN ABSOLUTE MINIMUM OF 1M, OVER A MAXIMUM LENGTH OF 6M) SHOULD BE MAINTAINED DURING SITE CLEARANCE
 - ALL EXISTING LIGHTING COLUMNS, ILLUMINATED BOLLARDS OR ROAD SIGNS ARE TO BE DISCONNECTED AND MADE SAFE BEFORE REMOVALS
 - CONTRACTOR TO ENSURE TREE ROOTS ARE PROTECTED DURING EXCAVATION WORKS AROUND TREES.
 - WAND ORCAS ARE TO BE POSITIONED ON THE INSIDE OF MANDATORY CYCLE LANE MARKINGS
 - MANDATORY CYCLE LANE DIMENSIONS ARE FROM THE KERB FACE TO THE OUTSIDE OF THE MANDATORY WHITE LINE MARKINGS

A	WH	23/06/20	Amendments to notes and drawing
B	WH	19/08/20	Amendments to notes and drawing
C	WH	09/10/20	Amendments to crossings and lanes
D	WH	26/10/20	Amendments to parking and loading

Rev	By	Date	Amendments
-----	----	------	------------


Camden
Design Team
Transport Strategy Service
London Borough of Camden
5 Pancras Square
Tel 020 7974 5551, Fax 020 7974 6952
DX 2106 Euston, Minicom 020 7974 6866

Project
**CYCLE POP-UP SCHEME
HAVERSTOCK HILL**

Drawing Title
GENERAL ARRANGEMENTS

Scale 1 : 200 @ A1	Date JUNE 2020
Drawn By WH	File Ref T:\Cap_Sm\2019\20/CYCLE POP-UP\Haverstock Hill
Checked By SS	Dwg Name CYCLE POP-UP

Drawing Location -	Drawing Number SSF/000-CS-100-01-008	Rev. D
-----------------------	---	-----------

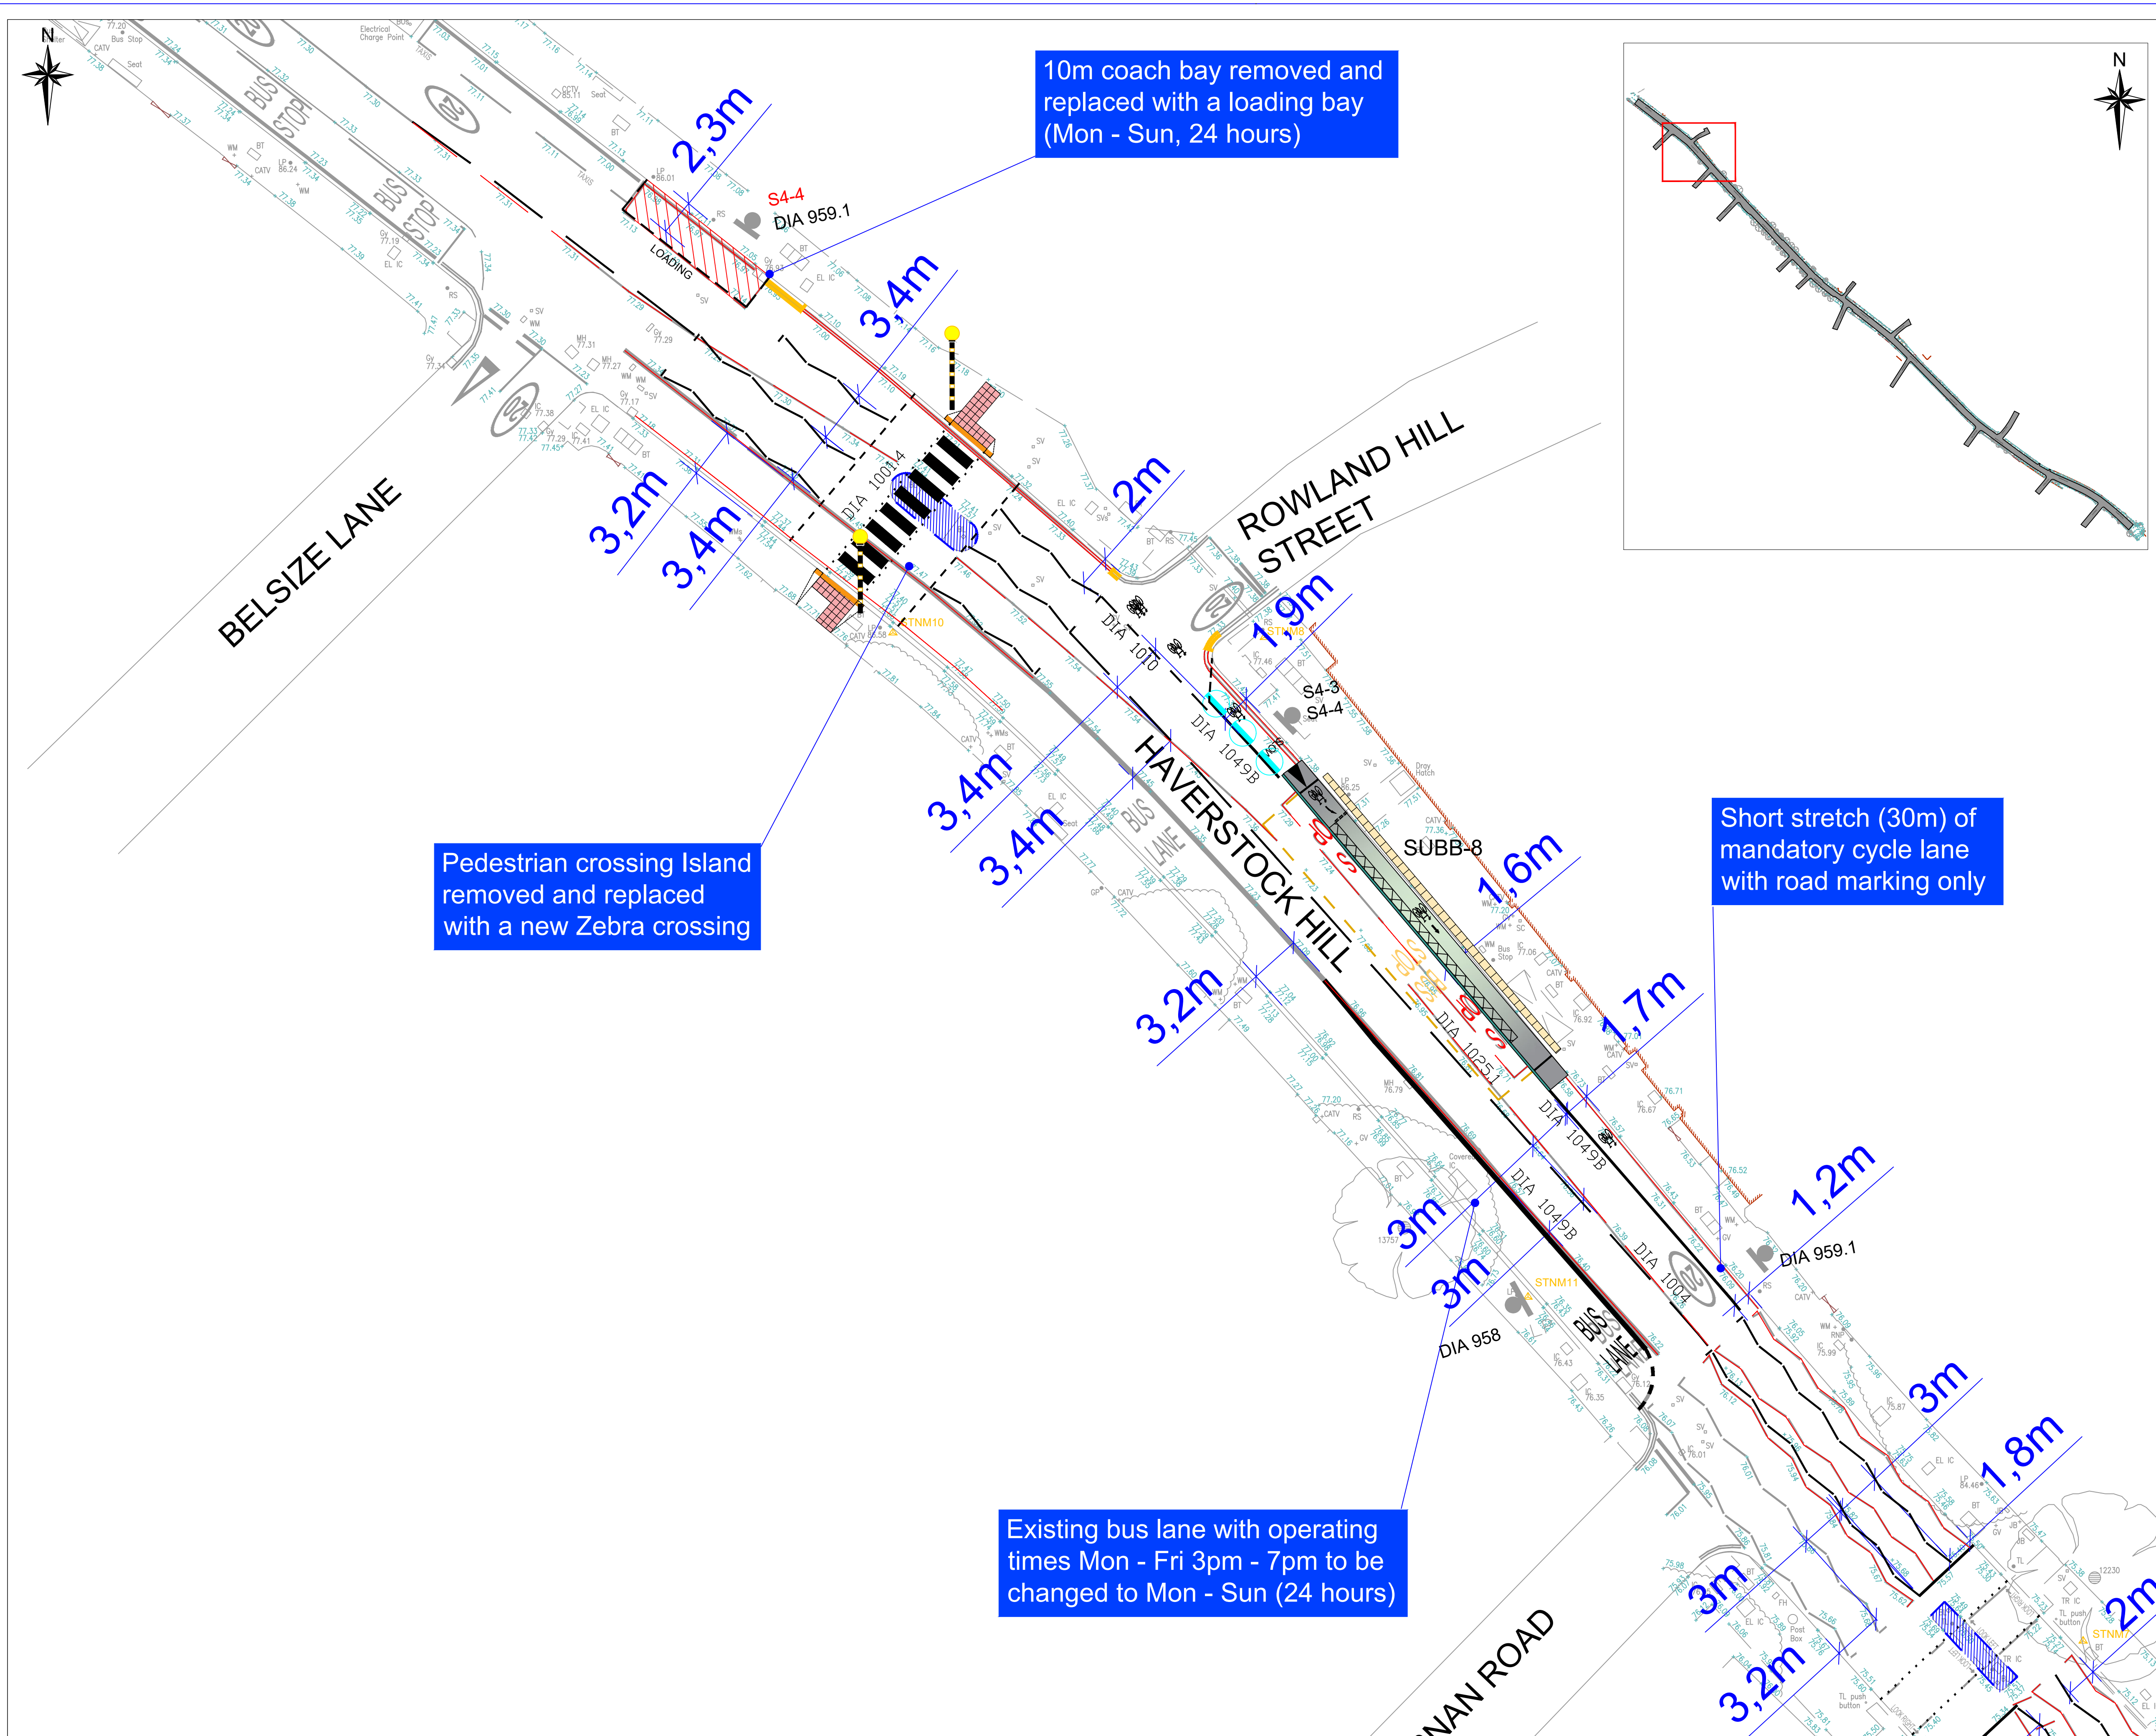

- KEY:**
- NEW DOUBLE YELLOW LINE MARKING / EXISTING TO BE REFRESHED
 - ROAD MARKINGS TO BE REMOVED
 - EXISTING LAYOUT TO BE RETAINED
 - TRAFFIC ISLAND TO BE REMOVED
 - PARKING BAY REMOVED
 - ELECTRIC VEHICLE CHARGING BAY REMOVED
 - CAR CLUB BAYS REMOVED
 - DISABLED BAYS REMOVED
 - DIS
 - NEW DISABLED BAY 3HRS MAX STAY
 - NEW OR REVISED PARKING BAY
 - NEW ELECTRIC VEHICLE CHARGING BAY
 - NEW CAR CLUB BAY
 - KERBS TO BE REMOVED
 - NEW KERBS LINE
 - NEW DROPPED KERB
 - NEW ARTIFICIAL STONE PAVING
 - NEW MASTIC ASPHALT PAVING
 - NEW PAVING BLOCKS
 - NEW BUFF TACTILE PAVING
 - NEW RED TACTILE PAVING
 - MANHOLE COVER REPLACED TO MATCH NEW USE
 - MANHOLE DROPPED TO MATCH SURROUNDING LEVELS AND COVER REPLACED TO MATCH NEW USE
 - MANHOLE RAISED TO MATCH SURROUNDING LEVELS AND COVER RETAINED
 - TACTILE PAVING TO BE REMOVED
 - NEW 24/7 MANDATORY CYCLE LANES AND CYCLE LAYOUTS (DIA 1007)
 - DIA 0000
 - INSTALL TRAFFIC SIGNS REGULATION AND GENERAL DIRECTION DIAGRAM NUMBER
 - S4-0-0
 - REMOVE TRAFFIC SIGNS REGULATION AND GENERAL DIRECTION DIAGRAM NUMBER TO STORAGE
 - EXISTING LAMP COLUMN AND NEW SIGNS
 - NEW POST AND SIGN
 - EXISTING POST AND SIGN
 - NEW SHARED USE BUS BOARDERS (SUBB) WITH TACTILE PAVING
 - NEW ZEBRA CROSSING (DIA 1001.4)
 - WAND ORCAS INSTALLED @ 2.5M SPACING
 - NEW BELISHA BEACON

- NOTES:**
- ALL ITEMS SHOWN RED ARE TO BE REMOVED, GREY ARE TO BE MAINTAINED AND BLACK ARE TO BE INSTALLED AS PART OF WORK
 - THIS DRAWING IS BASED ON CD SURVEYS LTD TOPOGRAPHICAL SURVEY DRAWING NO. 2008045 - HAVERSTOCK HILL, LONDON FINAL
 - THIS AND ALL DRAWINGS ARE TO BE READ IN CONJUNCTION WITH THE SPECIFICATION FOR HIGHWAY WORKS AND OTHER SCHEME DRAWINGS
 - IF IN DOUBT OF ANY ASPECT OF THE DESIGN REFER TO THE LEAD DESIGNER FOR CLARIFICATION
 - EXISTING ACCESSES SHOULD BE MAINTAINED AT ALL TIMES AND NOT OBSTRUCTED UNLESS WITH PRIOR CONSENT FROM AFFECTED PARTIES
 - A MINIMUM FOOTWAY WIDTH OF 1.5M (OR AN ABSOLUTE MINIMUM OF 1M, OVER A MAXIMUM LENGTH OF 6M) SHOULD BE MAINTAINED DURING SITE CLEARANCE
 - ALL EXISTING LIGHTING COLUMNS, ILLUMINATED BOLLARDS OR ROAD SIGNS ARE TO BE DISCONNECTED AND MADE SAFE BEFORE REMOVALS
 - CONTRACTOR TO ENSURE TREE ROOTS ARE PROTECTED DURING EXCAVATION WORKS AROUND TREES.
 - WAND ORCAS ARE TO BE POSITIONED ON THE INSIDE OF MANDATORY CYCLE LANE MARKINGS
 - MANDATORY CYCLE LANE DIMENSIONS ARE FROM THE KERB FACE TO THE OUTSIDE OF THE MANDATORY WHITE LINE MARKINGS

A	WH	23/06/20	Amendments to notes and drawing
B	WH	19/08/20	Amendments to notes and drawing
C	WH	09/10/20	Amendments to crossings and lanes
D	WH	26/10/20	Amendments to parking and loading

Rev	By	Date	Amendments
-----	----	------	------------




Design Team
Transport Strategy Service
London Borough of Camden
5 Pancras Square
Tel 020 7974 5551, Fax 020 7974 6952
DX 2106 Euston, Minicom 020 7974 6866

Project
**CYCLE POP-UP SCHEME
HAVERSTOCK HILL**

Drawing Title
GENERAL ARRANGEMENTS

Scale 1 : 200 @ A1	Date JUNE 2020
Drawn By WH	File Ref T:\Cap_Sm2019\2019\CYCLE POP-UP\Haverstock Hill
Checked By SS	Dwg Name CYCLE POP-UP

Drawing Location -	Drawing Number SSF/000-CS-100-01-009	Rev. D
-----------------------	---	-----------

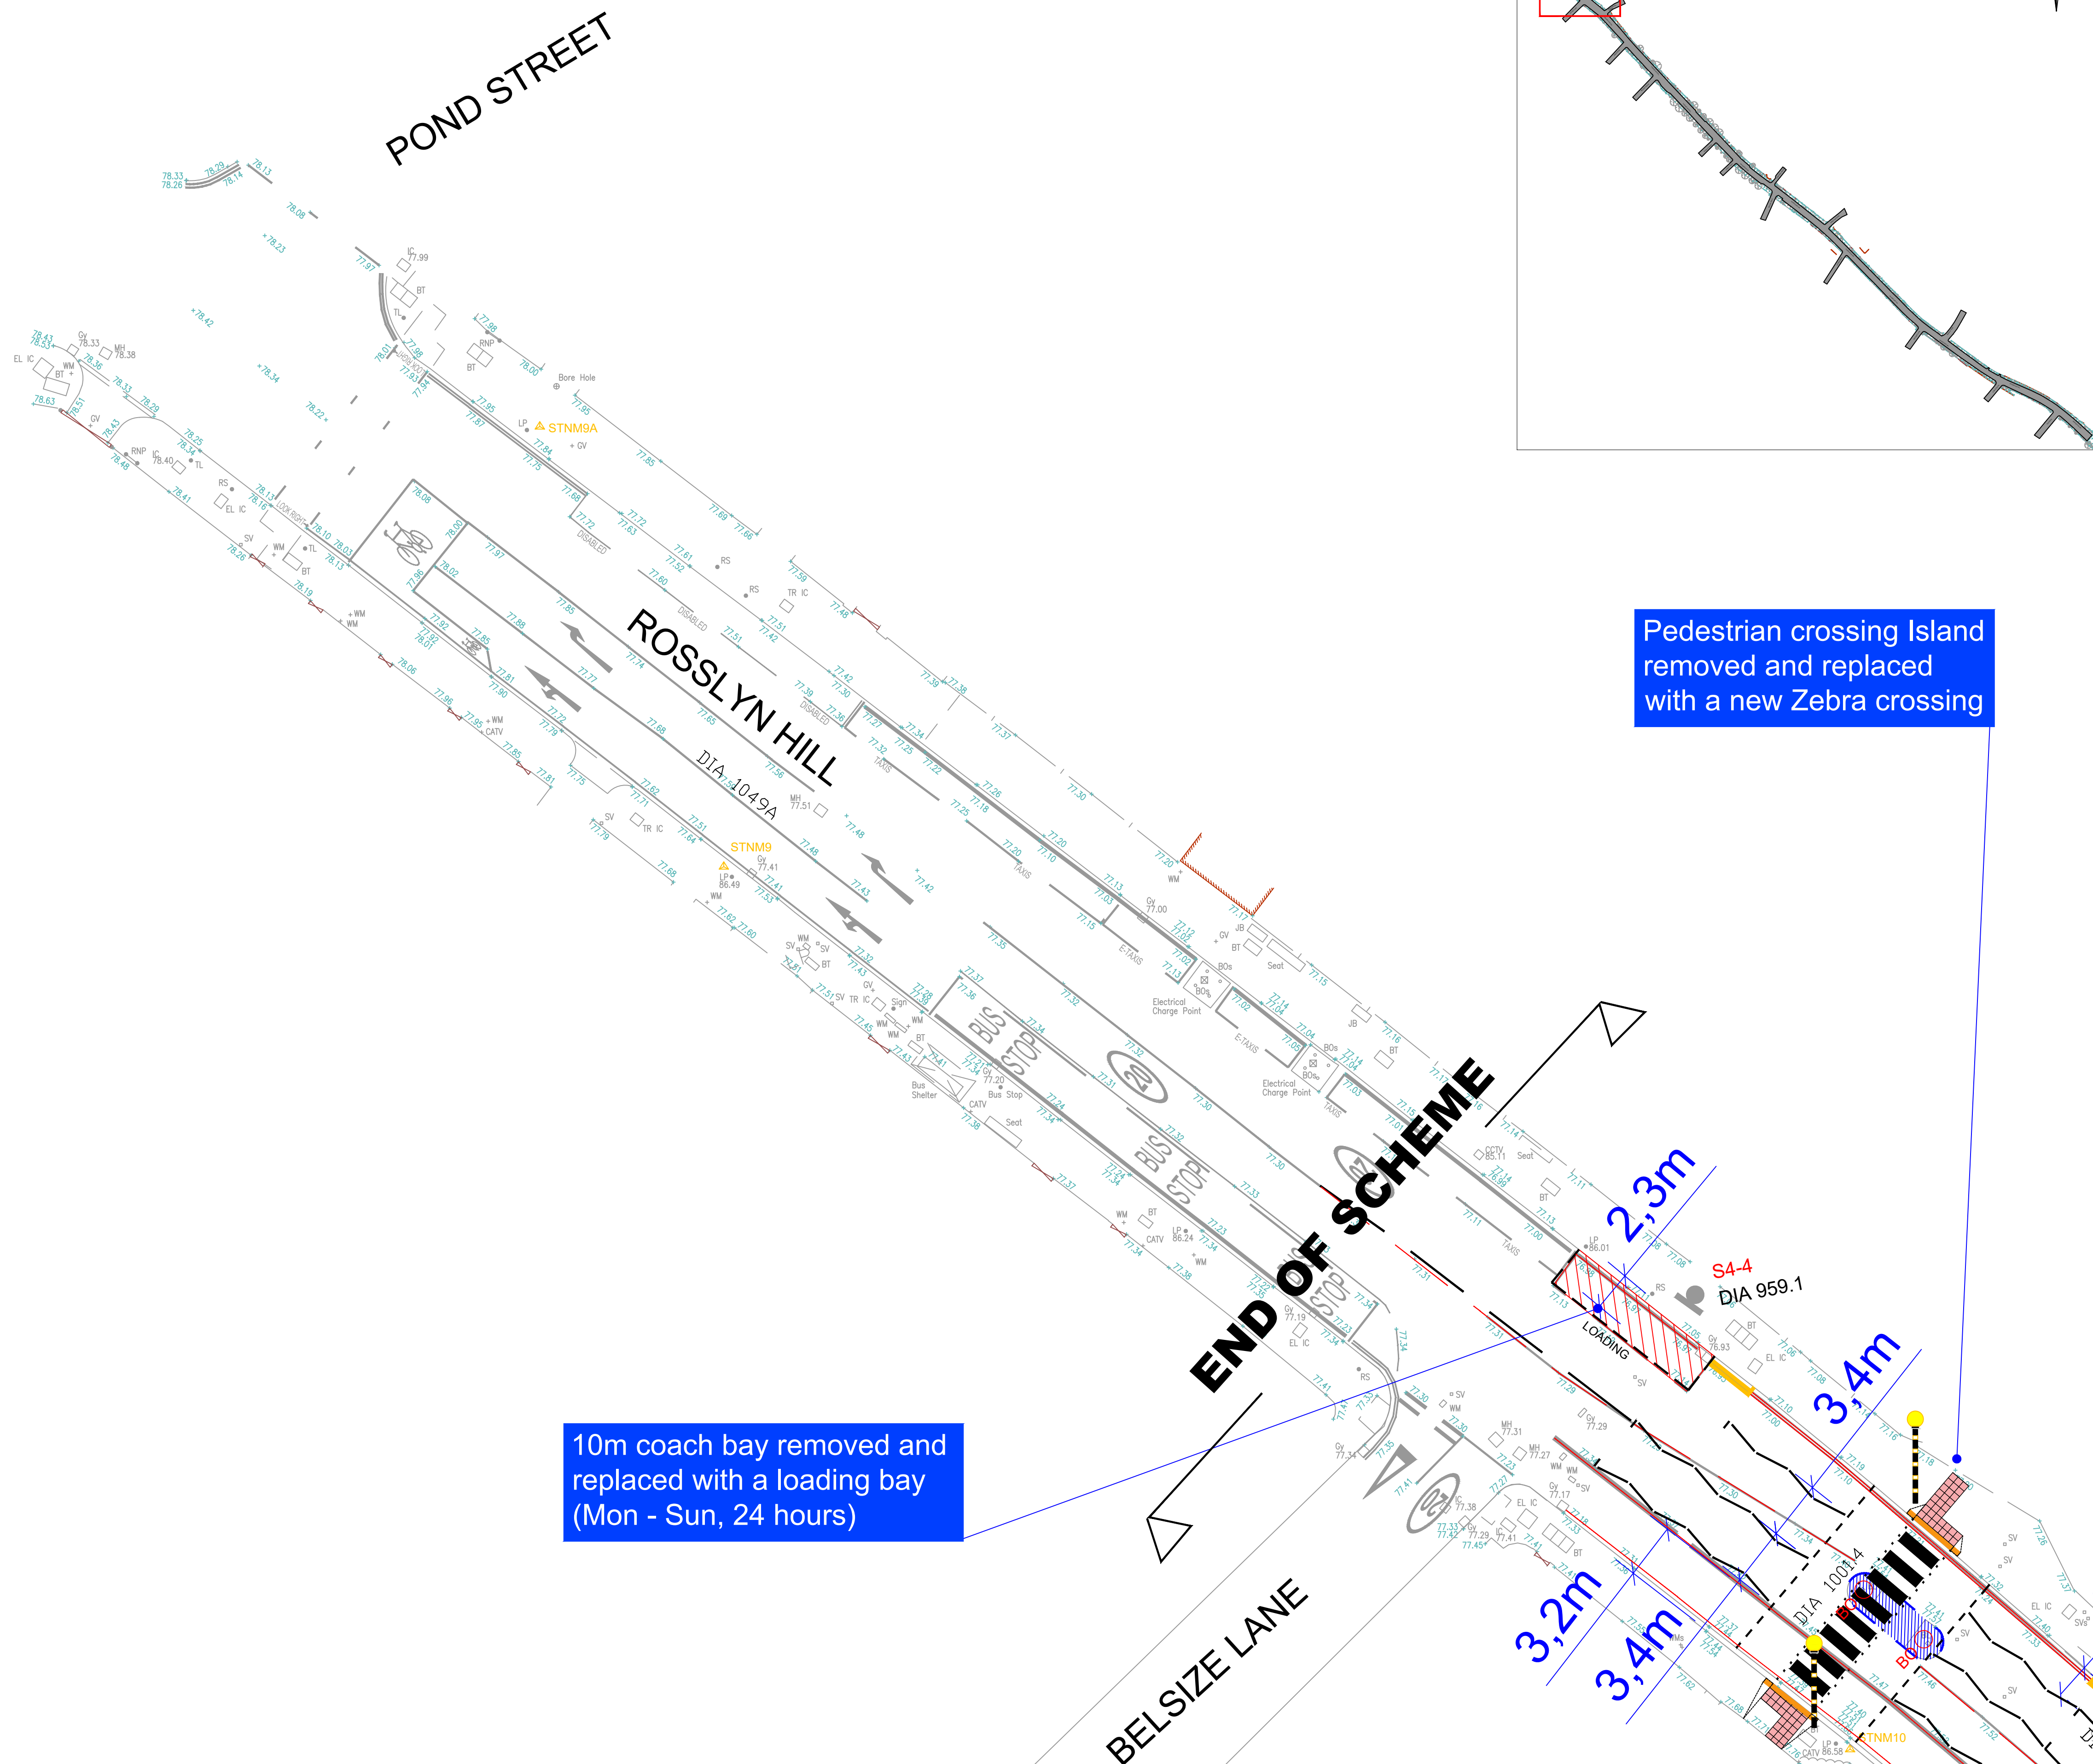

Pedestrian crossing Island removed and replaced with a new Zebra crossing

10m coach bay removed and replaced with a loading bay (Mon - Sun, 24 hours)

- KEY:**
- NEW DOUBLE YELLOW LINE MARKING / EXISTING TO BE REFRESHED
 - ROAD MARKINGS TO BE REMOVED
 - EXISTING LAYOUT TO BE RETAINED
 - TRAFFIC ISLAND TO BE REMOVED
 - PARKING BAY REMOVED
 - ELECTRIC VEHICLE CHARGING BAY REMOVED
 - CAR CLUB BAYS REMOVED
 - DISABLED BAYS REMOVED
 - DIS
 - NEW DISABLED BAY 3HRS MAX STAY
 - NEW OR REVISED PARKING BAY
 - NEW ELECTRIC VEHICLE CHARGING BAY
 - NEW CAR CLUB BAY
 - KERBS TO BE REMOVED
 - NEW KERBS LINE
 - NEW DROPPED KERB
 - NEW ARTIFICIAL STONE PAVING
 - NEW MASTIC ASPHALT PAVING
 - NEW PAVING BLOCKS
 - NEW BUFF TACTILE PAVING
 - NEW RED TACTILE PAVING
 - MANHOLE COVER REPLACED TO MATCH NEW USE
 - MANHOLE DROPPED TO MATCH SURROUNDING LEVELS AND COVER REPLACED TO MATCH NEW USE
 - MANHOLE RAISED TO MATCH SURROUNDING LEVELS AND COVER RETAINED
 - TACTILE PAVING TO BE REMOVED
 - NEW 247 MANDATORY CYCLE LANES AND CYCLE LOGOS (DIA 1057)
 - DIA 0000
 - INSTALL TRAFFIC SIGNS REGULATION AND GENERAL DIRECTION DIAGRAM NUMBER
 - S4-0-0
 - REMOVE TRAFFIC SIGNS REGULATION AND GENERAL DIRECTION DIAGRAM NUMBER TO STORAGE
 - EXISTING LAMP COLUMN AND NEW SIGNS
 - NEW POST AND SIGN
 - EXISTING POST AND SIGN
 - NEW SHARED USE BUS BOARDERS (SUBB) WITH TACTILE PAVING
 - NEW ZEBRA CROSSING (DIA 1001.4)
 - WAND ORCAS INSTALLED @ 2.5M SPACING
 - NEW BELISHA BEACON

- NOTES:**
- ALL ITEMS SHOWN RED ARE TO BE REMOVED, GREY ARE TO BE MAINTAINED AND BLACK ARE TO BE INSTALLED AS PART OF WORK
 - THIS DRAWING IS BASED ON CD SURVEYS LTD TOPOGRAPHICAL SURVEY DRAWING NO. 2008045 - HAVERSTOCK HILL, LONDON FINAL
 - THIS AND ALL DRAWINGS ARE TO BE READ IN CONJUNCTION WITH THE SPECIFICATION FOR HIGHWAY WORKS AND OTHER SCHEME DRAWINGS
 - IF IN DOUBT OF ANY ASPECT OF THE DESIGN REFER TO THE LEAD DESIGNER FOR CLARIFICATION
 - EXISTING ACCESSES SHOULD BE MAINTAINED AT ALL TIMES AND NOT OBSTRUCTED UNLESS WITH PRIOR CONSENT FROM AFFECTED PARTIES
 - A MINIMUM FOOTWAY WIDTH OF 1.5M (OR AN ABSOLUTE MINIMUM OF 1M, OVER A MAXIMUM LENGTH OF 6M) SHOULD BE MAINTAINED DURING SITE CLEARANCE
 - ALL EXISTING LIGHTING COLUMNS, ILLUMINATED BOLLARDS OR ROAD SIGNS ARE TO BE DISCONNECTED AND MADE SAFE BEFORE REMOVALS
 - CONTRACTOR TO ENSURE TREE ROOTS ARE PROTECTED DURING EXCAVATION WORKS AROUND TREES.
 - WAND ORCAS ARE TO BE POSITIONED ON THE INSIDE OF MANDATORY CYCLE LANE MARKINGS
 - MANDATORY CYCLE LANE DIMENSIONS ARE FROM THE KERB FACE TO THE OUTSIDE OF THE MANDATORY WHITE LINE MARKINGS

A	WH	23/06/20	Amendments to notes and drawing
B	WH	19/08/20	Amendments to notes and drawing
C	WH	09/10/20	Amendments to crossings and lanes
D	WH	26/10/20	Amendments to parking and loading

Rev	By	Date	Amendments
-----	----	------	------------



Design Team
Transport Strategy Service
London Borough of Camden
5 Pancras Square
Tel 020 7974 5551, Fax 020 7974 6952
DX 2106 Euston, Minicom 020 7974 6866

Project
**CYCLE POP-UP SCHEME
HAVERSTOCK HILL**

Drawing Title
GENERAL ARRANGEMENTS

Scale 1 : 200 @ A1	Date JUNE 2020
Drawn By WH	File Ref T:\Cap_Sm\2019\20/CYCLE POP-UP/Haverstock H
Checked By SS	Dwg Name CYCLE POP-UP
Drawing Location -	

Drawing Number SSF/000-CS-100-01-010	Rev. D
--	------------------